

Form AI-187
March 1961

UNITED STATES
DEPARTMENT OF THE INTERIOR
BUREAU OF LAND MANAGEMENT

SECTION


18

NW 1/4 SE 1/4

Oregon State Water Filings

TOWNSHIP 35S, RANGE 22E, W. M.

North tied in with aerial photo and OSFO quad maps.

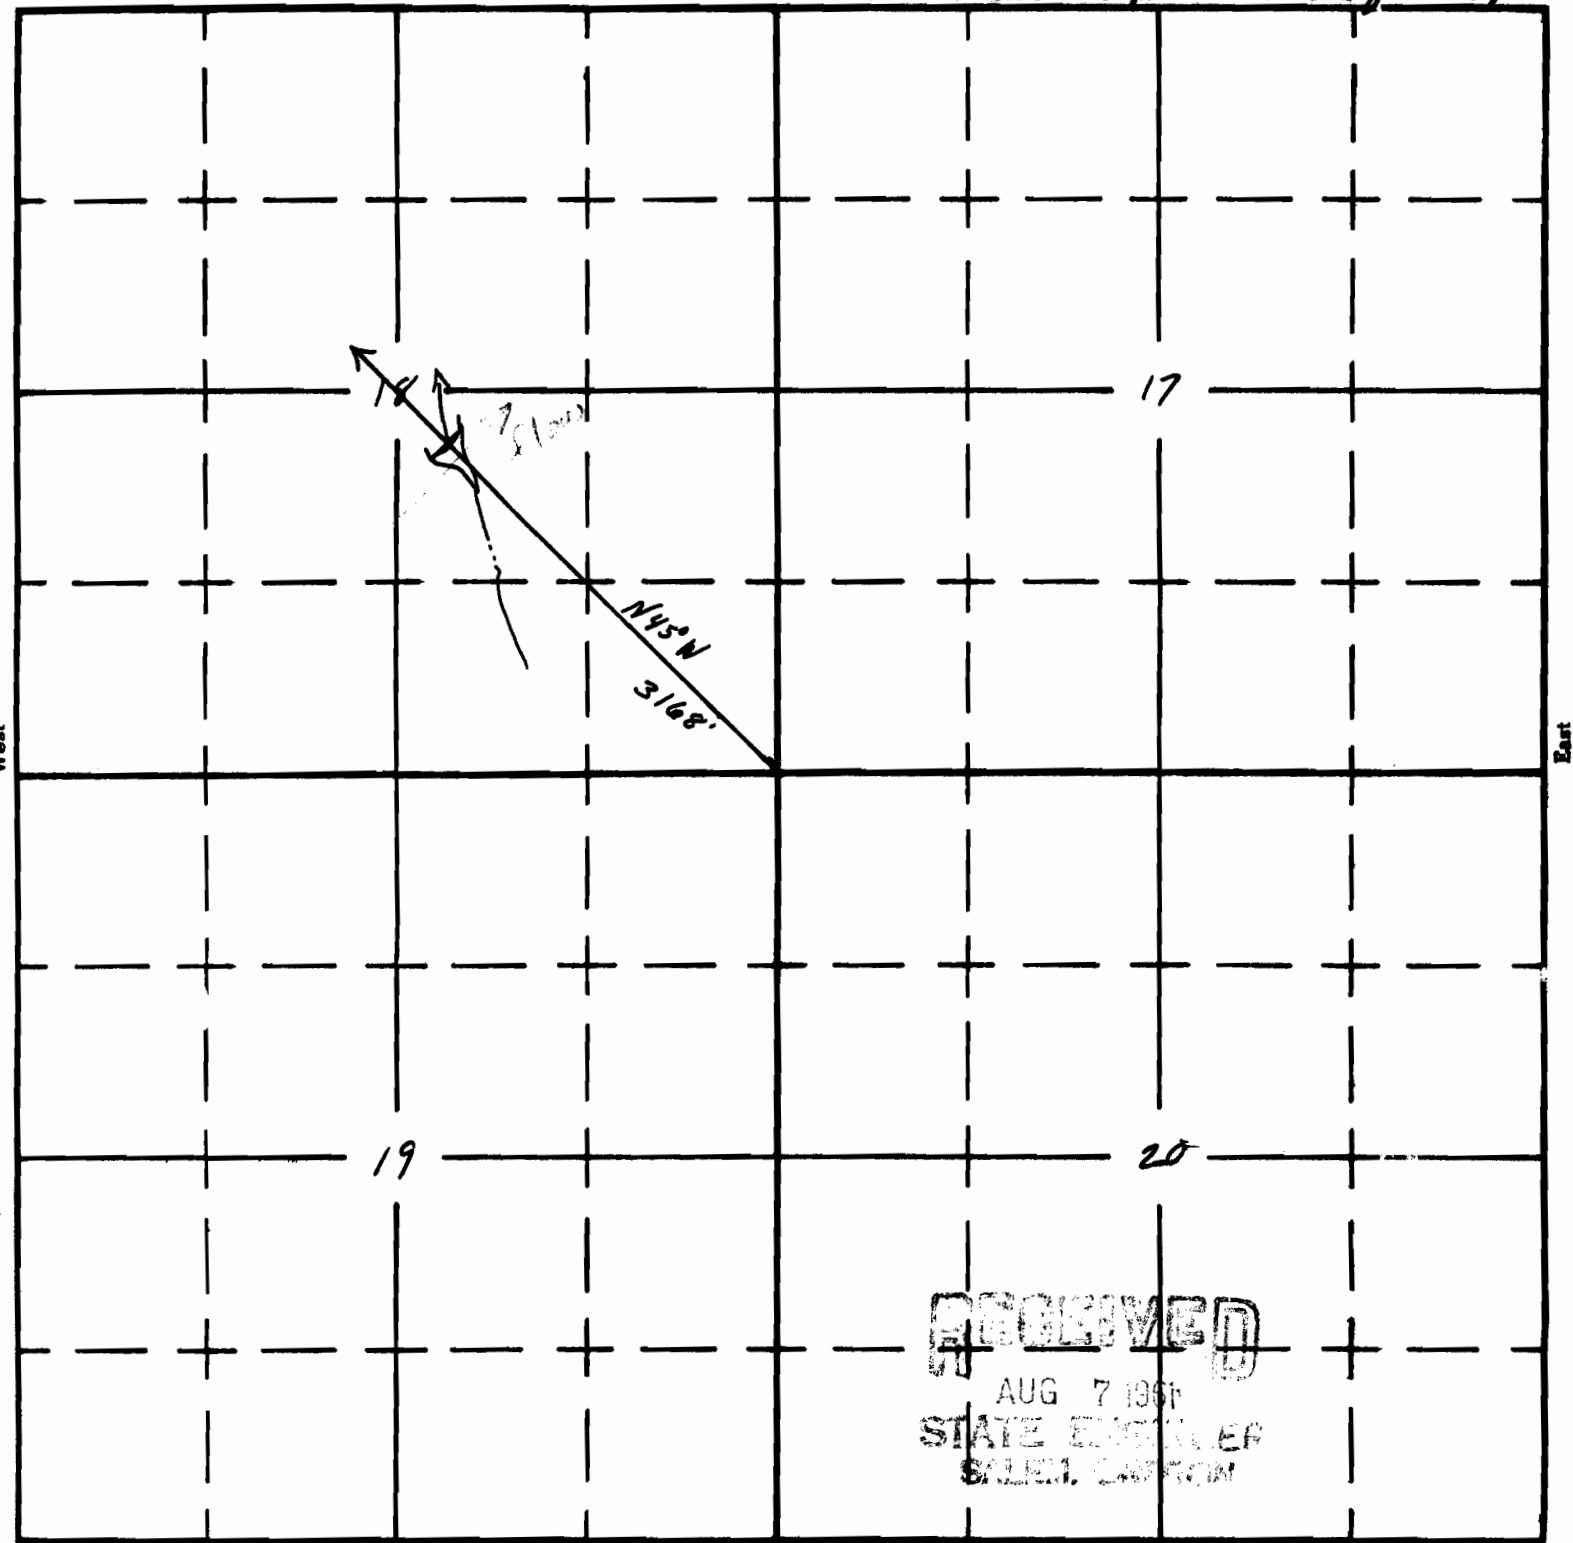

RECEIVED
AUG 7 1961
STATE ENGINEER
SALEM, OREGON

APPLICATION No. R-36217

PERMIT No. R-3576