

Form A1-187
March 1961

UNITED STATES
DEPARTMENT OF THE INTERIOR
BUREAU OF LAND MANAGEMENT

SECTION


18

NE¹/₄ NW¹/₄

Oregon State Water Filings

TOWNSHIP 35S, RANGE 22E, W. M.

North Tied in with aerial photo and USHD quad maps.

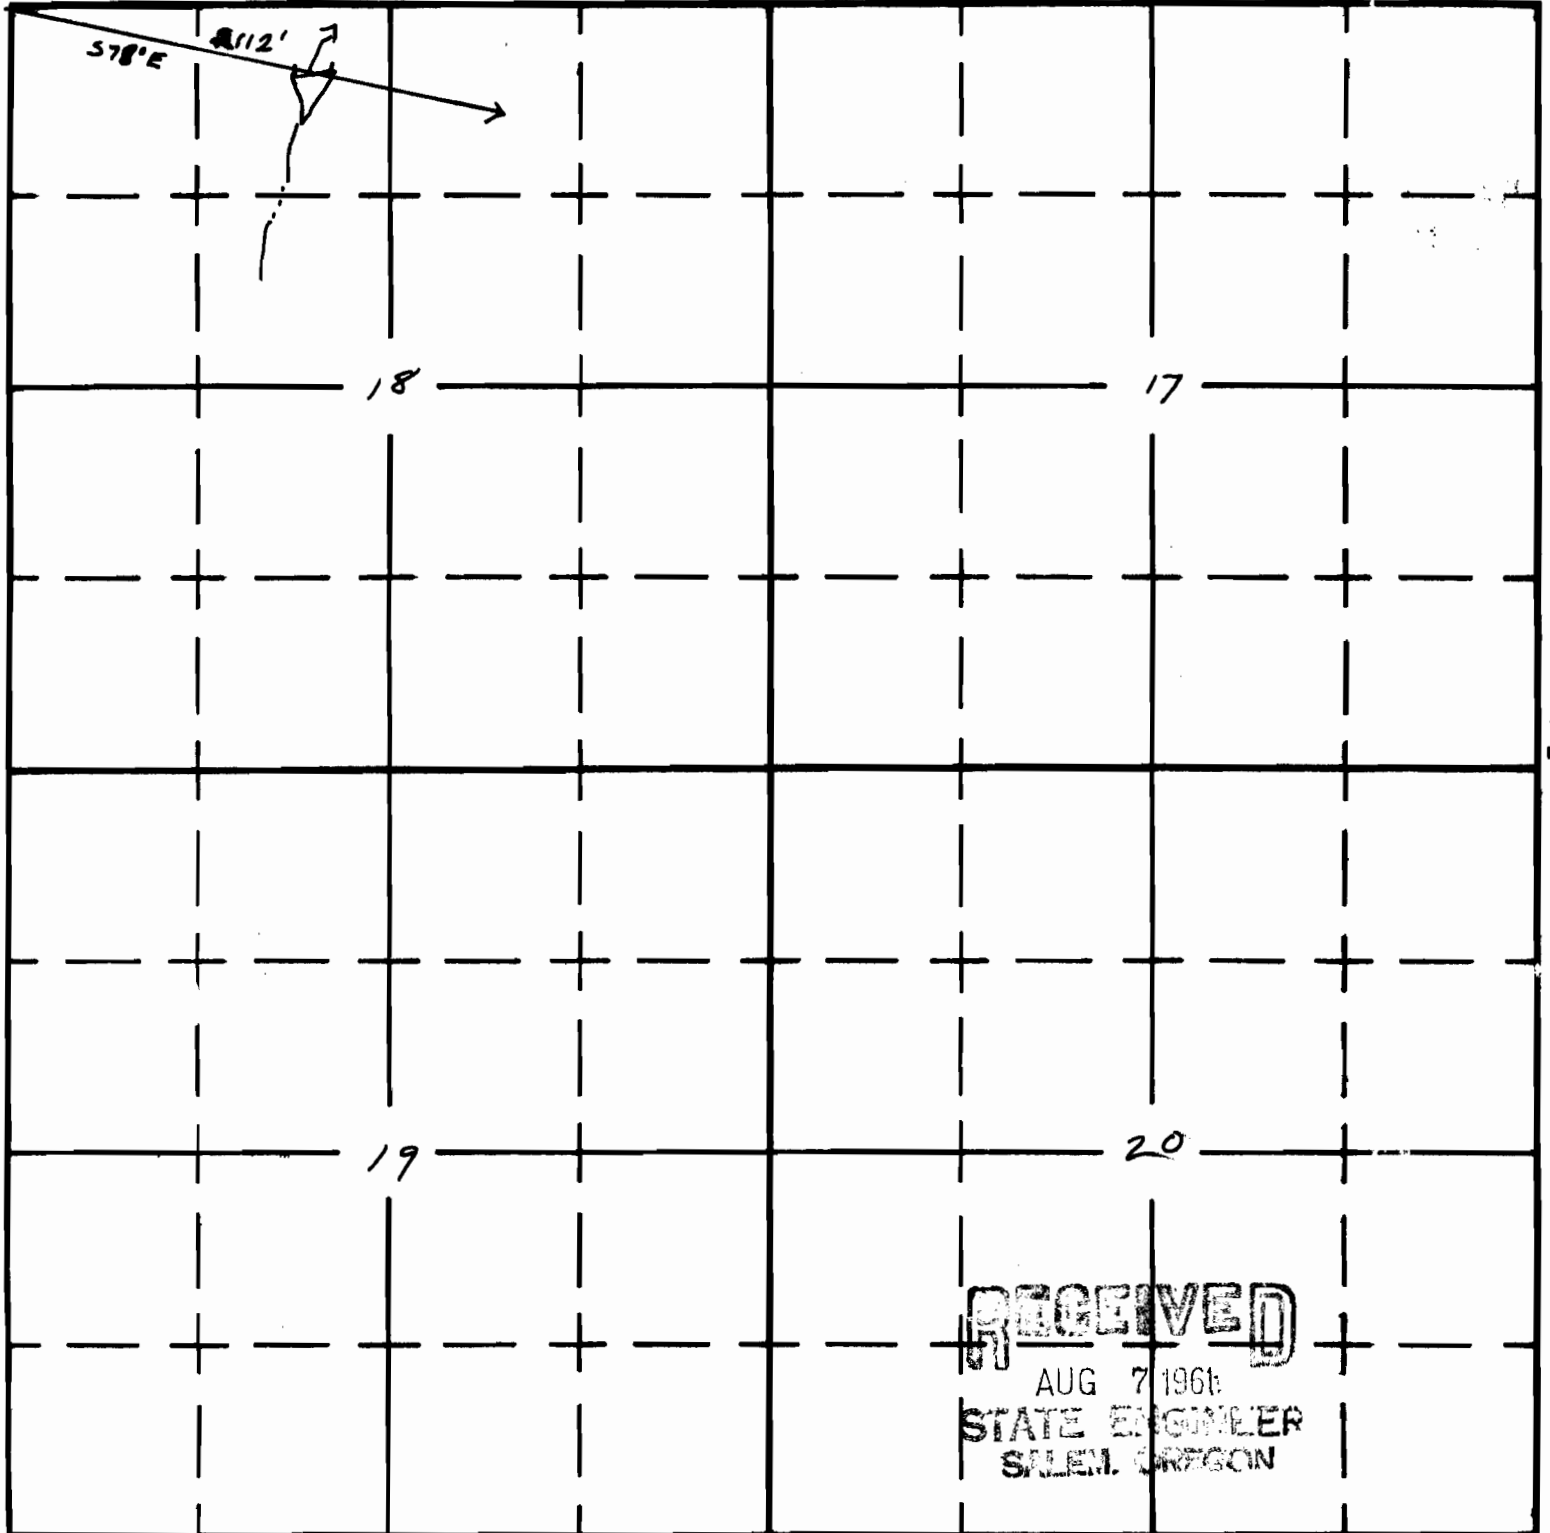

RECEIVED
AUG 7 1961
STATE ENGINEER
SALEM, OREGON

APPLICATION No. R-36218
PERMIT No. **R 7066**