

UNITED STATES
DEPARTMENT OF THE INTERIOR
BUREAU OF LAND MANAGEMENT

SECTION


5

Oregon State Water Filings

NE 1/4 SW 1/4

TOWNSHIP 35 S, RANGE 23 E, W. M.

Tied in with aerial photo & O.S.H.D. Quad Maps

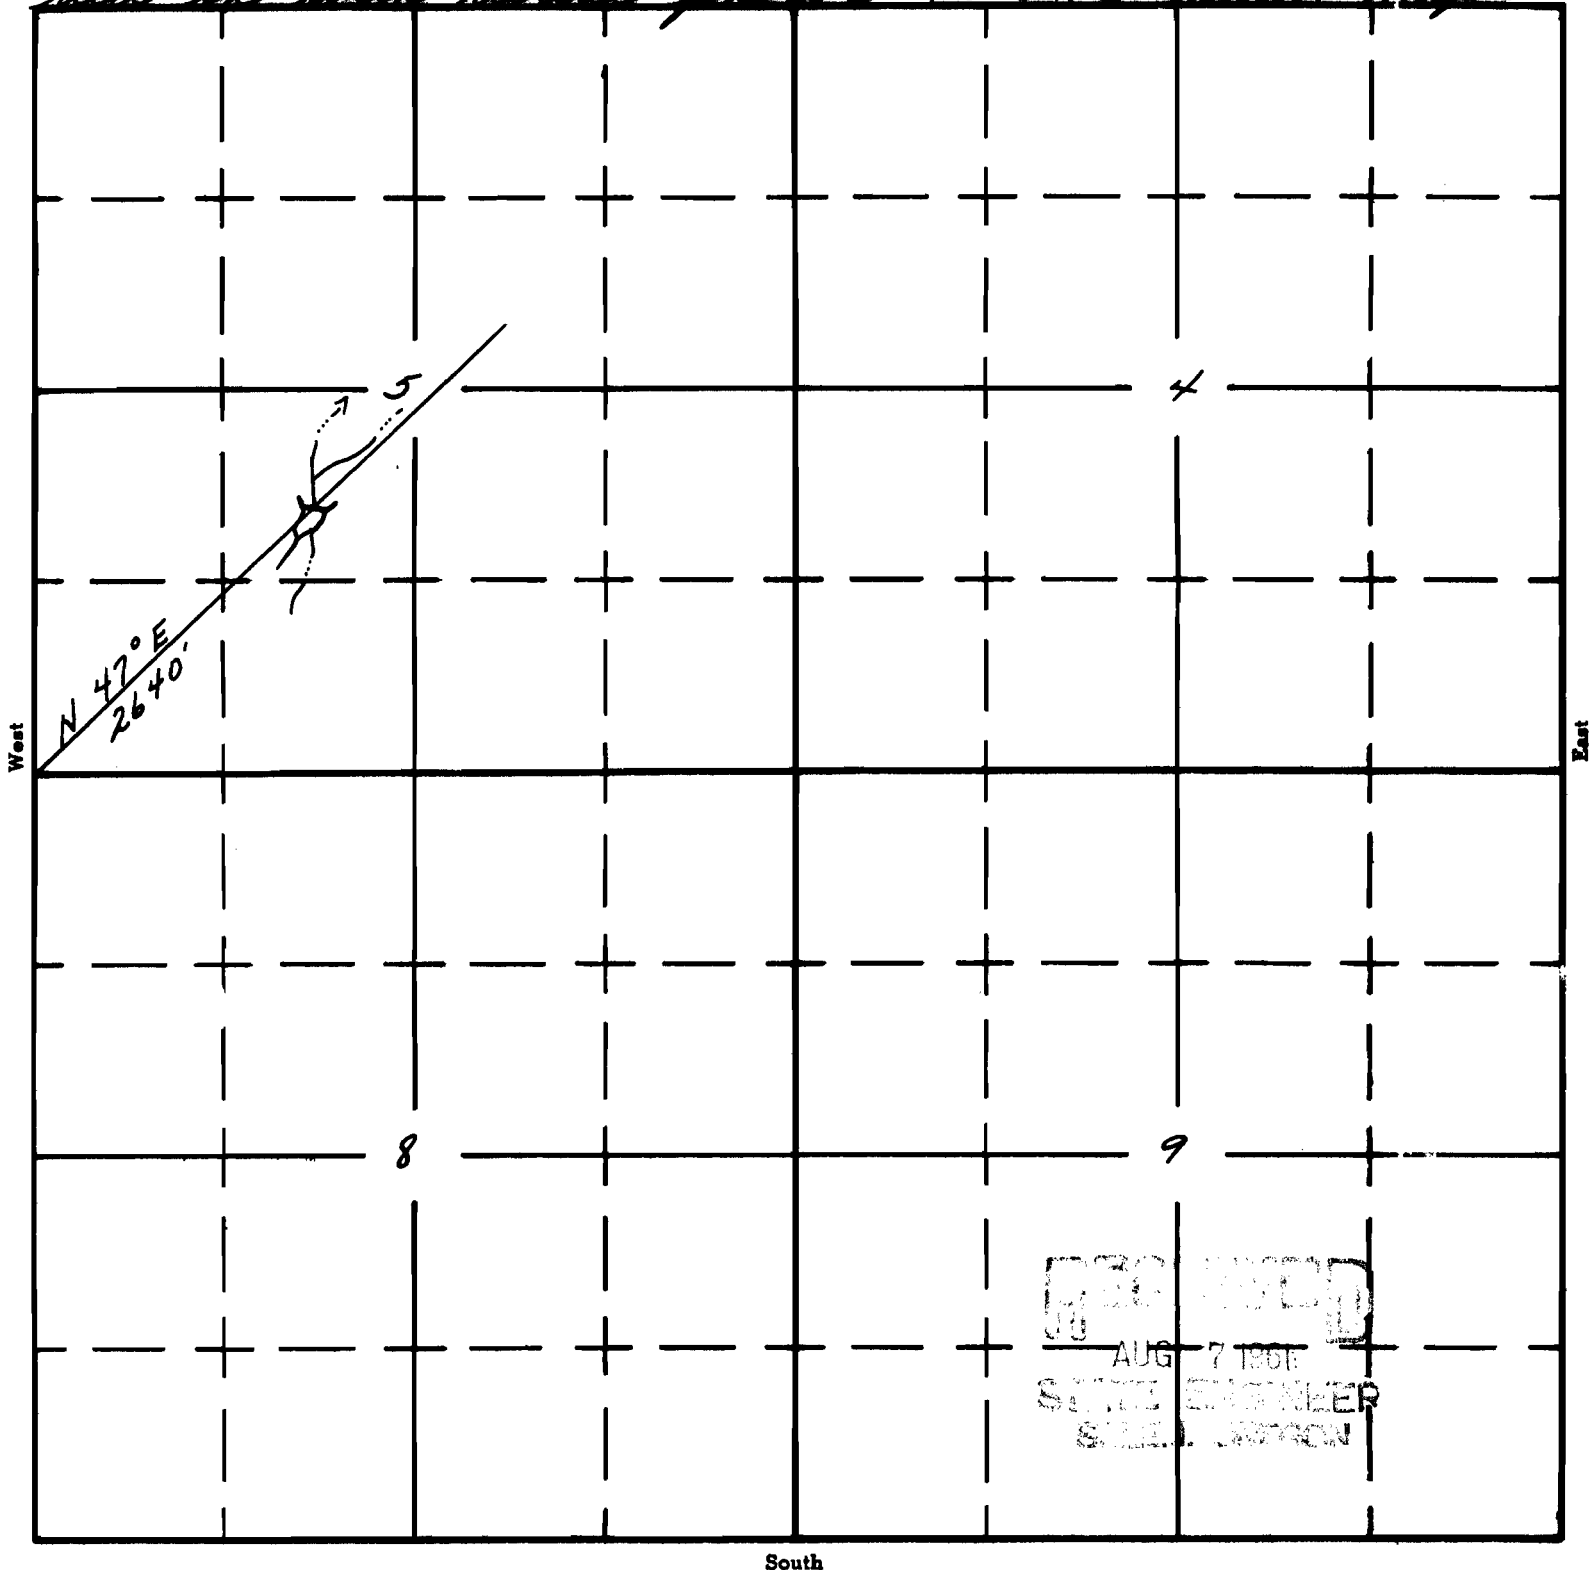

South

APPLICATION No. R.36221

PERMIT No. R 7068