

UNITED STATES
DEPARTMENT OF THE INTERIOR
BUREAU OF LAND MANAGEMENT

TR 3584
67404


SECTION

21
SE 4 NE 4

Oregon State Water Filings

TOWNSHIP 32S, RANGE 23E, W. M.

North *Tied in with aerial photo and DSHD Quad Maps.*

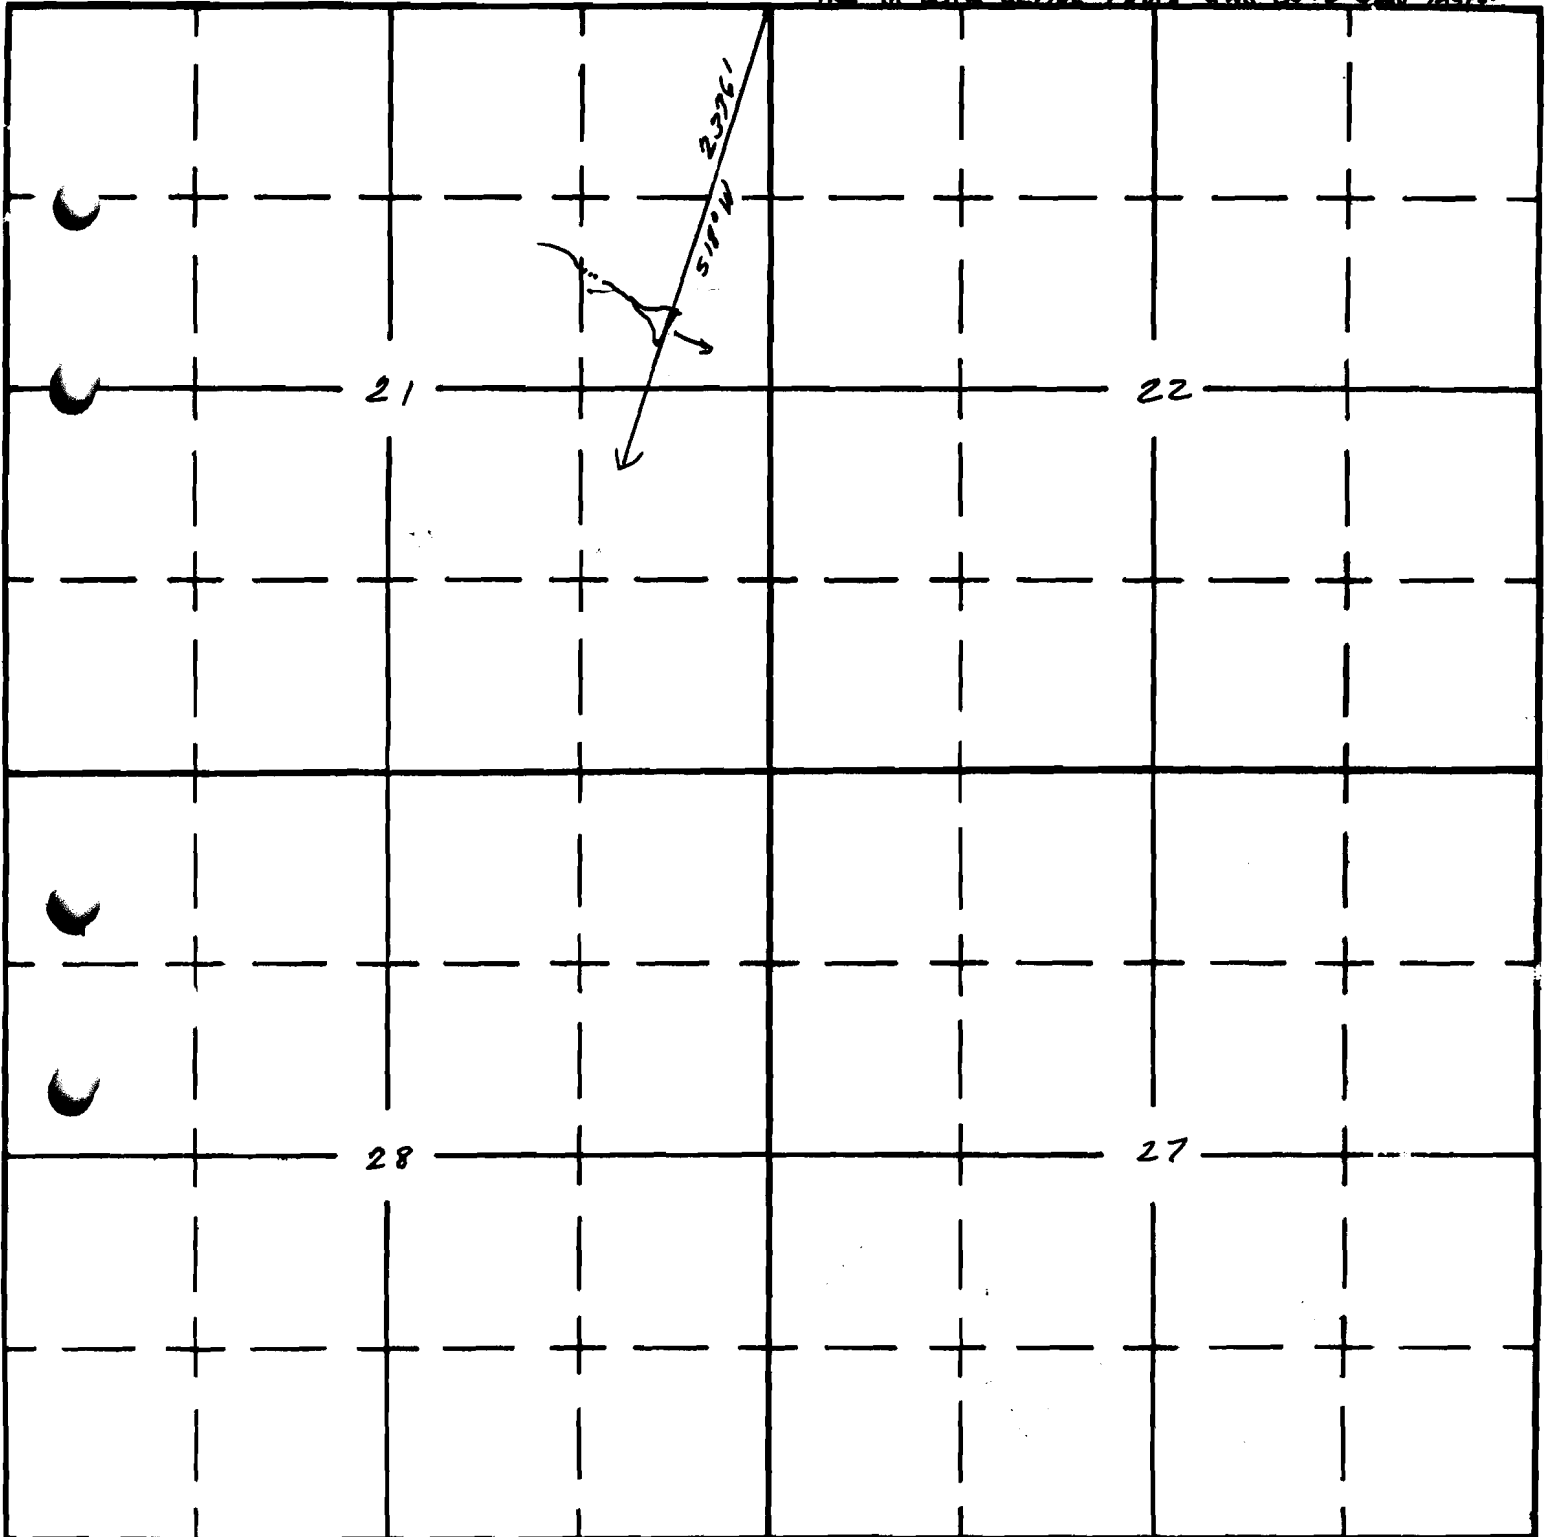

South

APPLICATION No. R-3625
PERMIT No. R-3584