

Form AI-187
March 1961

UNITED STATES
DEPARTMENT OF THE INTERIOR
BUREAU OF LAND MANAGEMENT


SECTION

Sec. 23

SE 1/4, NE 1/4

Oregon State Water Filings

TOWNSHIP 32 S., RANGE 23 E., W. M.

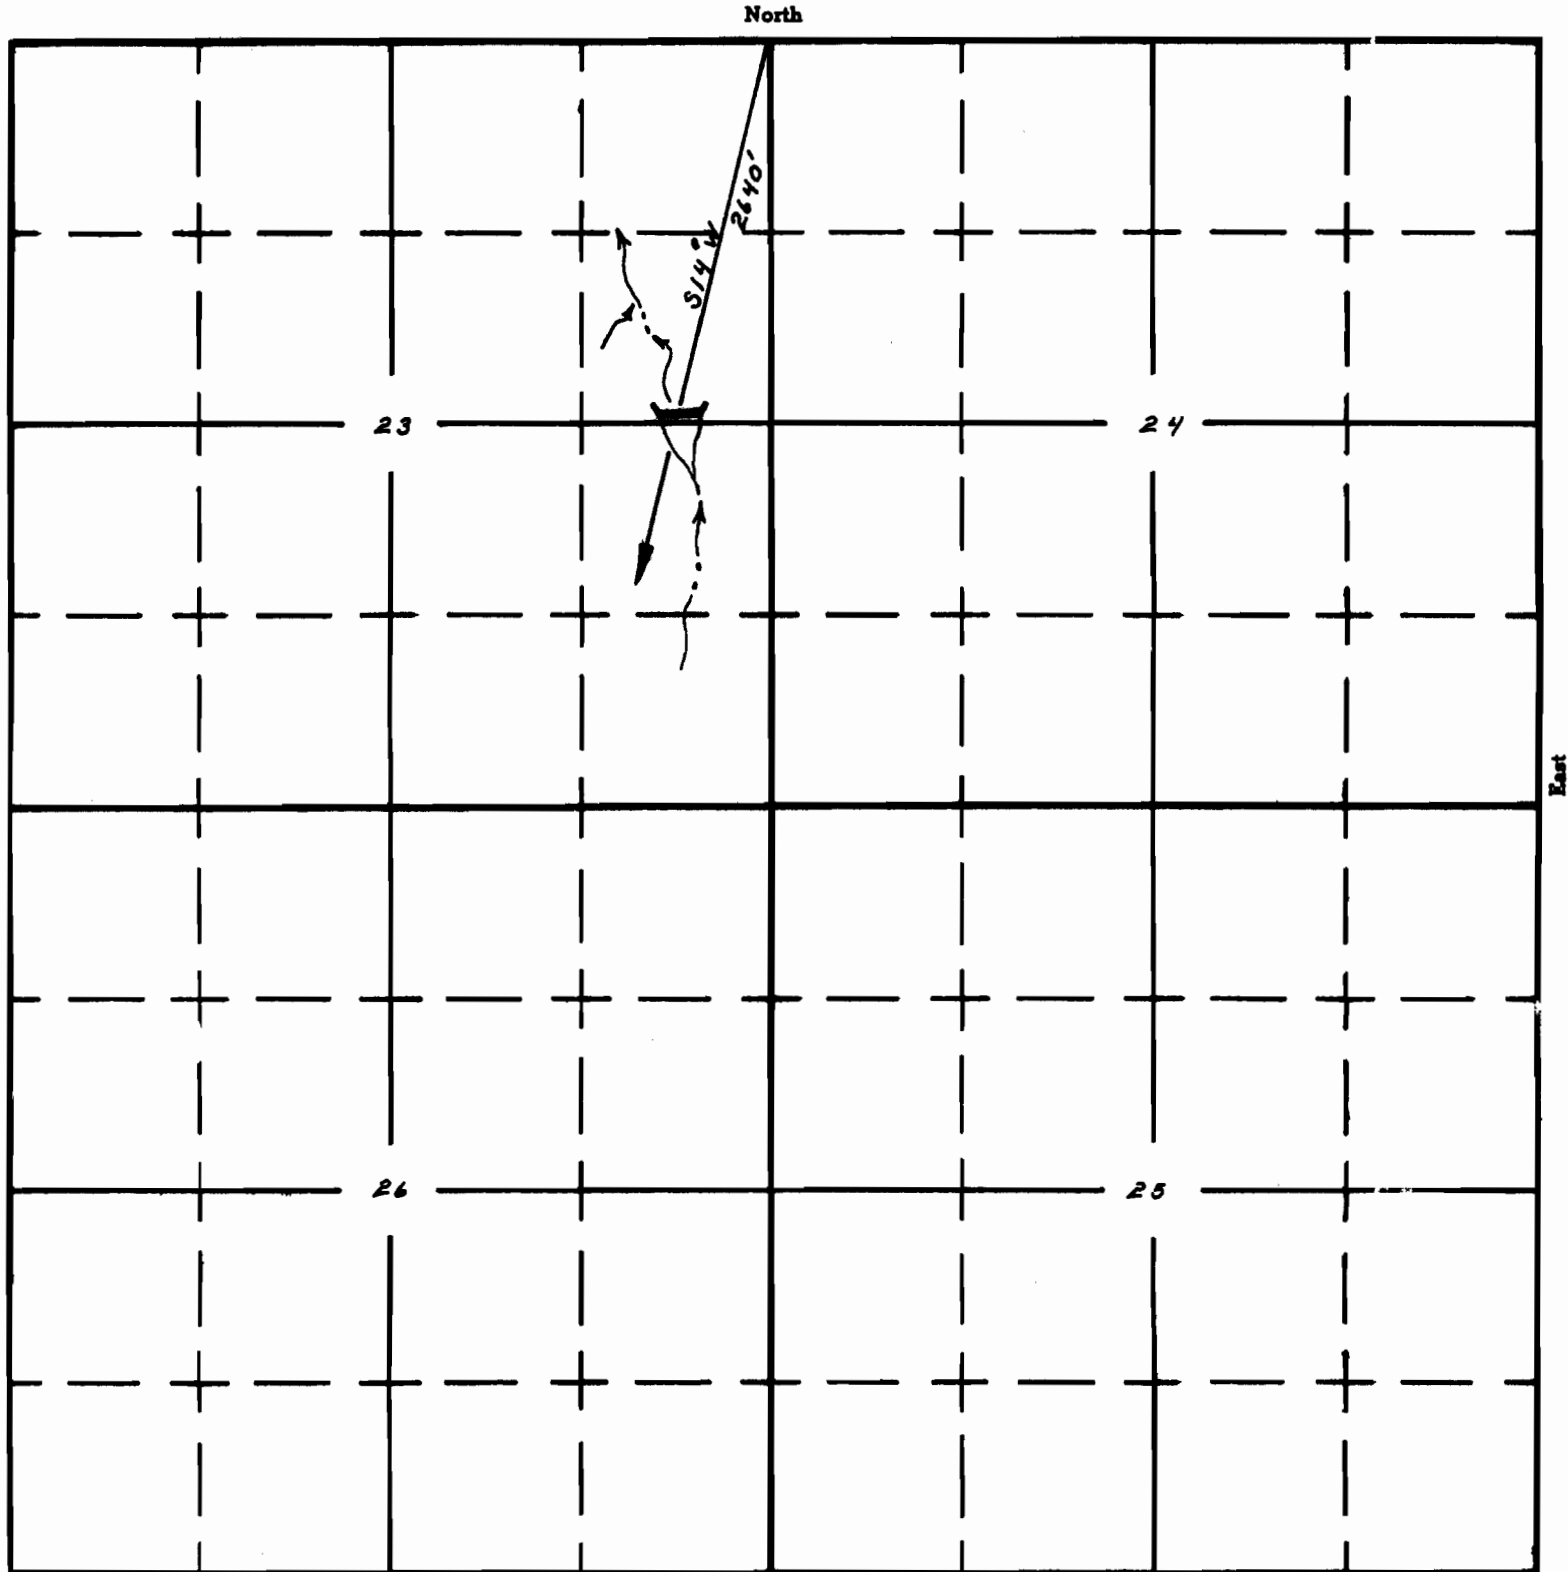

Sheep Draw Water hole

91 - 160 - 129

APPLICATION No. A36258
PERMIT NoR 7088