


Form AI-187
March 1961

UNITED STATES
DEPARTMENT OF THE INTERIOR
BUREAU OF LAND MANAGEMENT

SECTION
Sec. 32
SE 1/4, SW 1/4

Oregon State Water Filings

TOWNSHIP 30S, RANGE 24E, W. M.

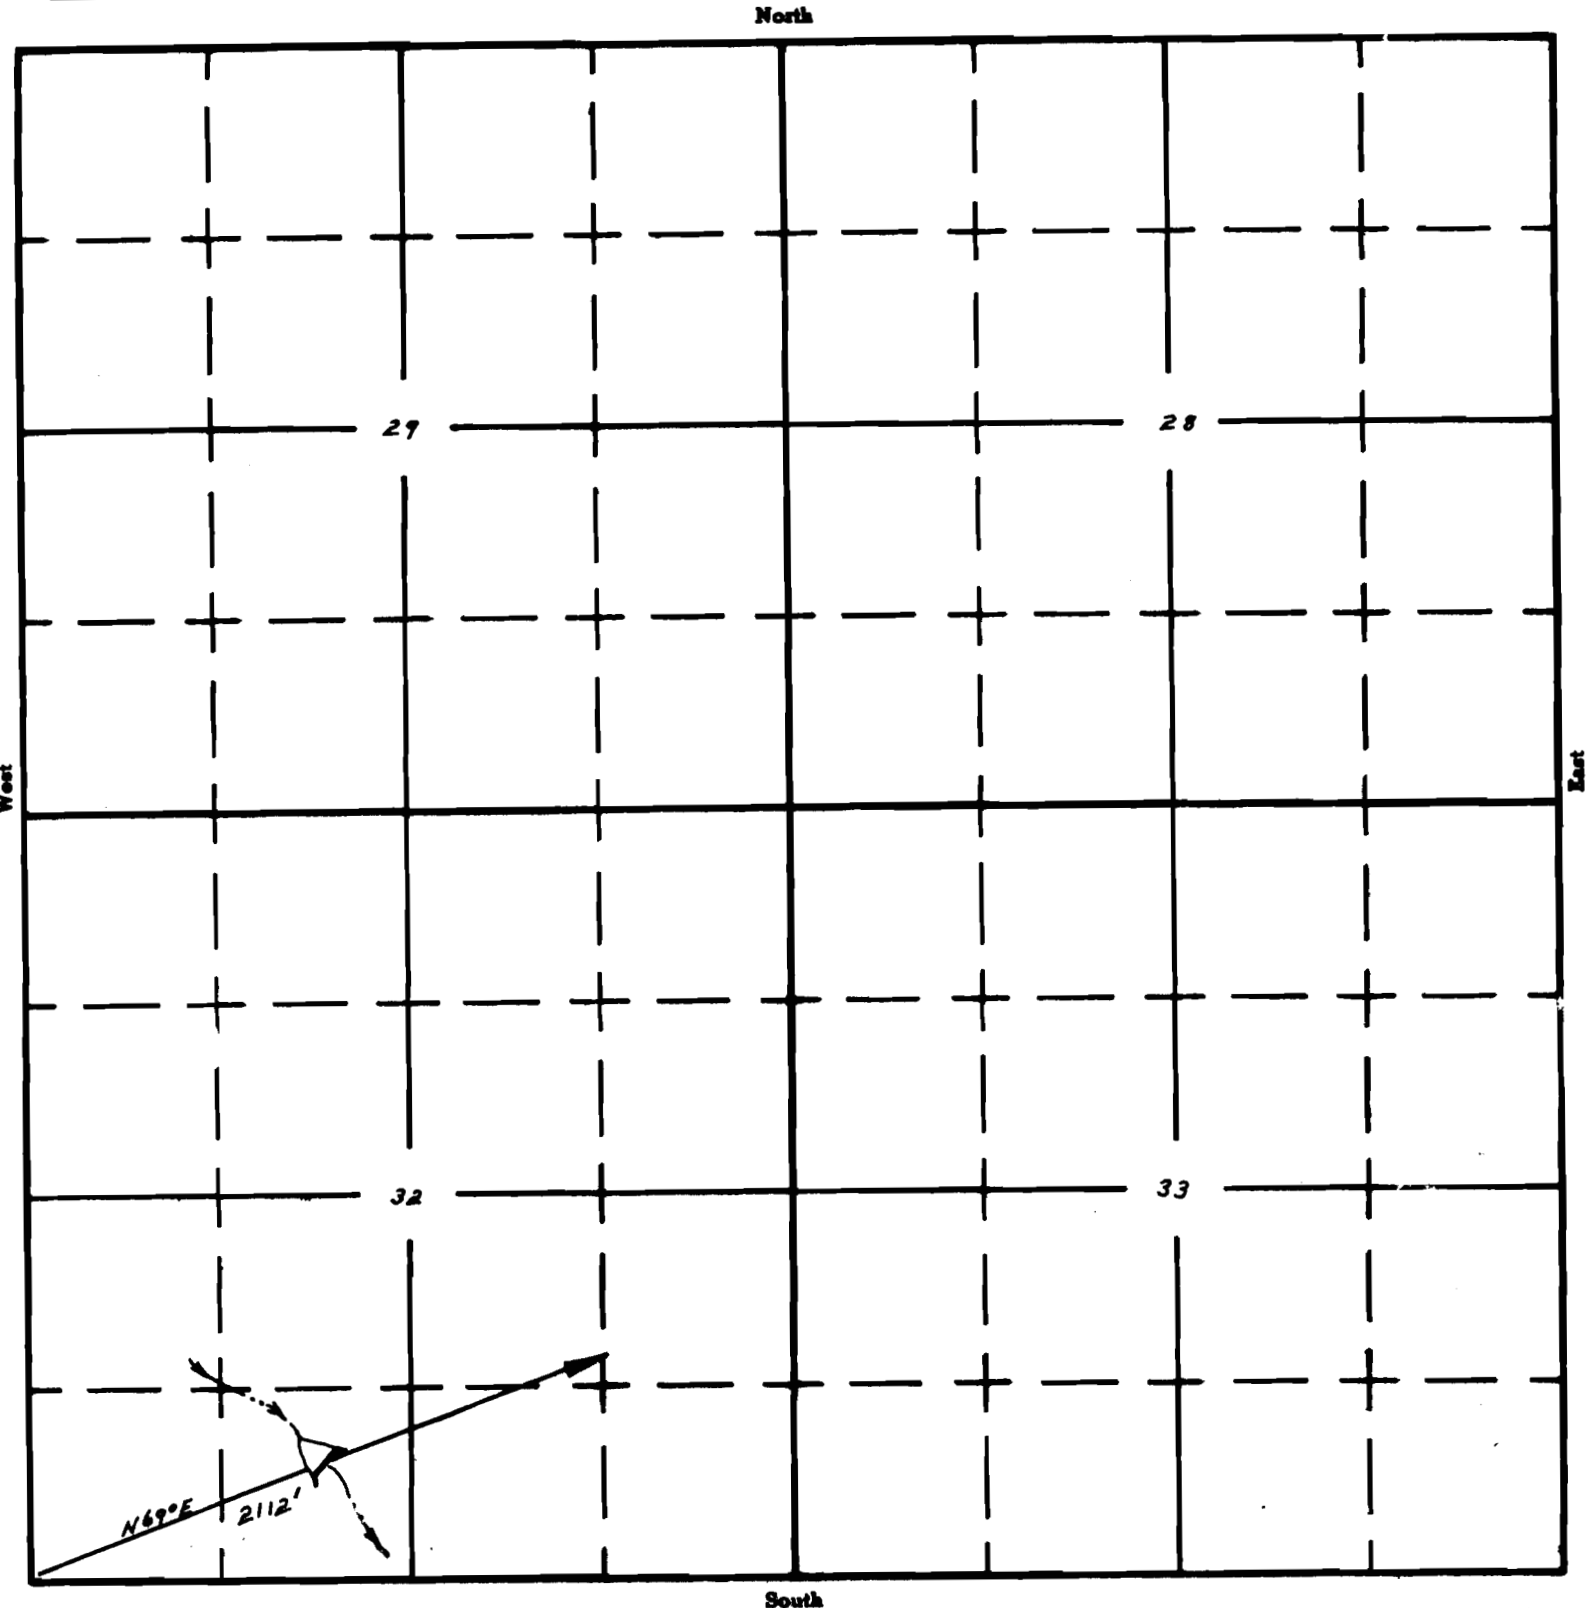

DeLee Waterhole
91-160-111

APPLICATION No. R36284
PERMIT No. R 7089