

UNITED STATES
DEPARTMENT OF THE INTERIOR
BUREAU OF LAND MANAGEMENT

SECTION

Sec. 6


NW 1/4, SE 1/4

Oregon State Water Filings

TOWNSHIP 34S, RANGE 24E, W. M.

DEC 1 1961

North

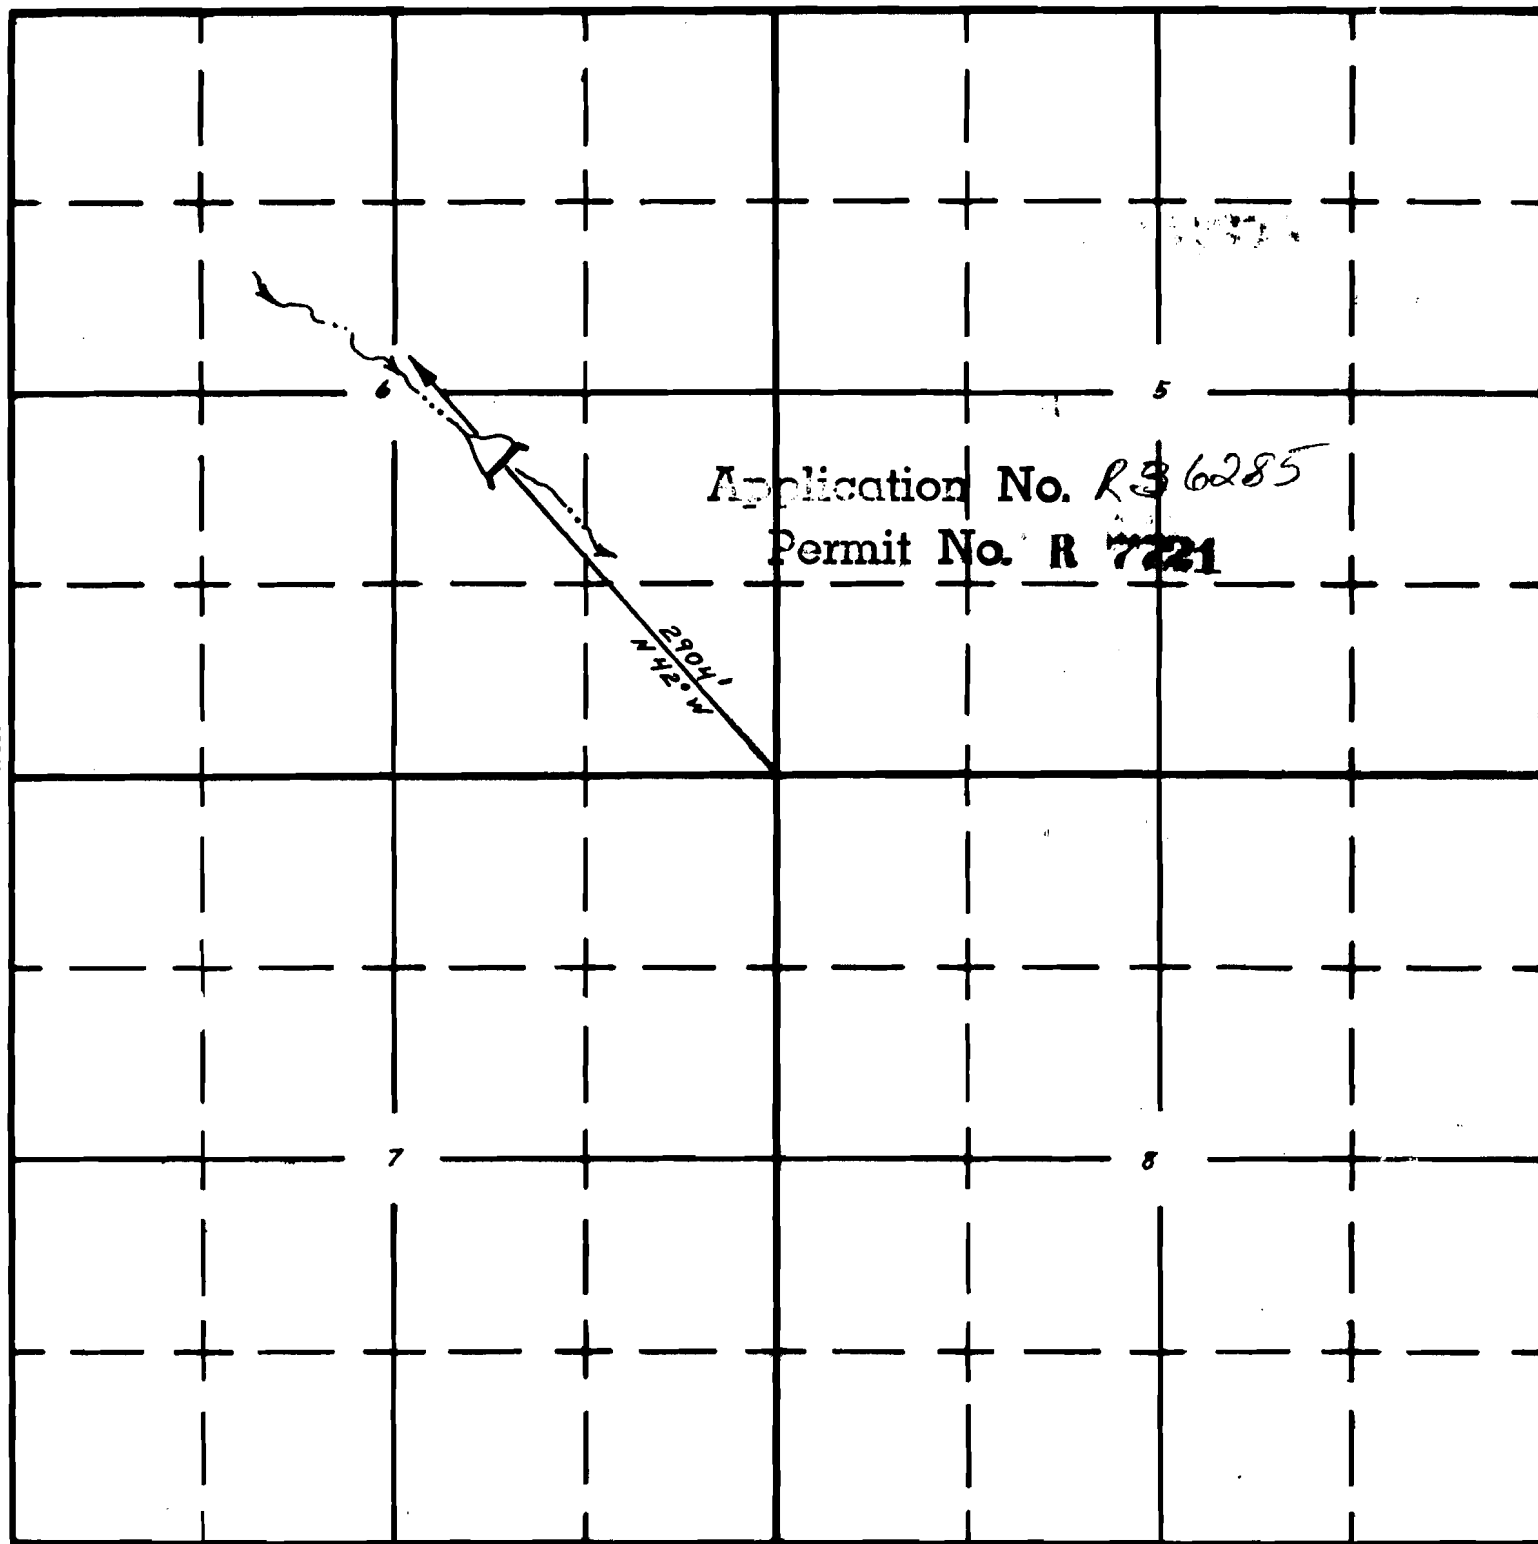

Segebrush Knoll Draw Water hole
91-160-116

South

APPLICATION No. R 36285
PERMIT No.