Form A1-187
March 1961


UNITED STATES
DEPARTMENT OF THE INTERIOR
BUREAU OF LAND MANAGEMENT

SECTION 32
SW¼ NW¼

Oregon State Water Filings

TOWNSHIP 28S, RANGE 25E, W. M.

North — Tied in with aerial photo and USGS quad maps.

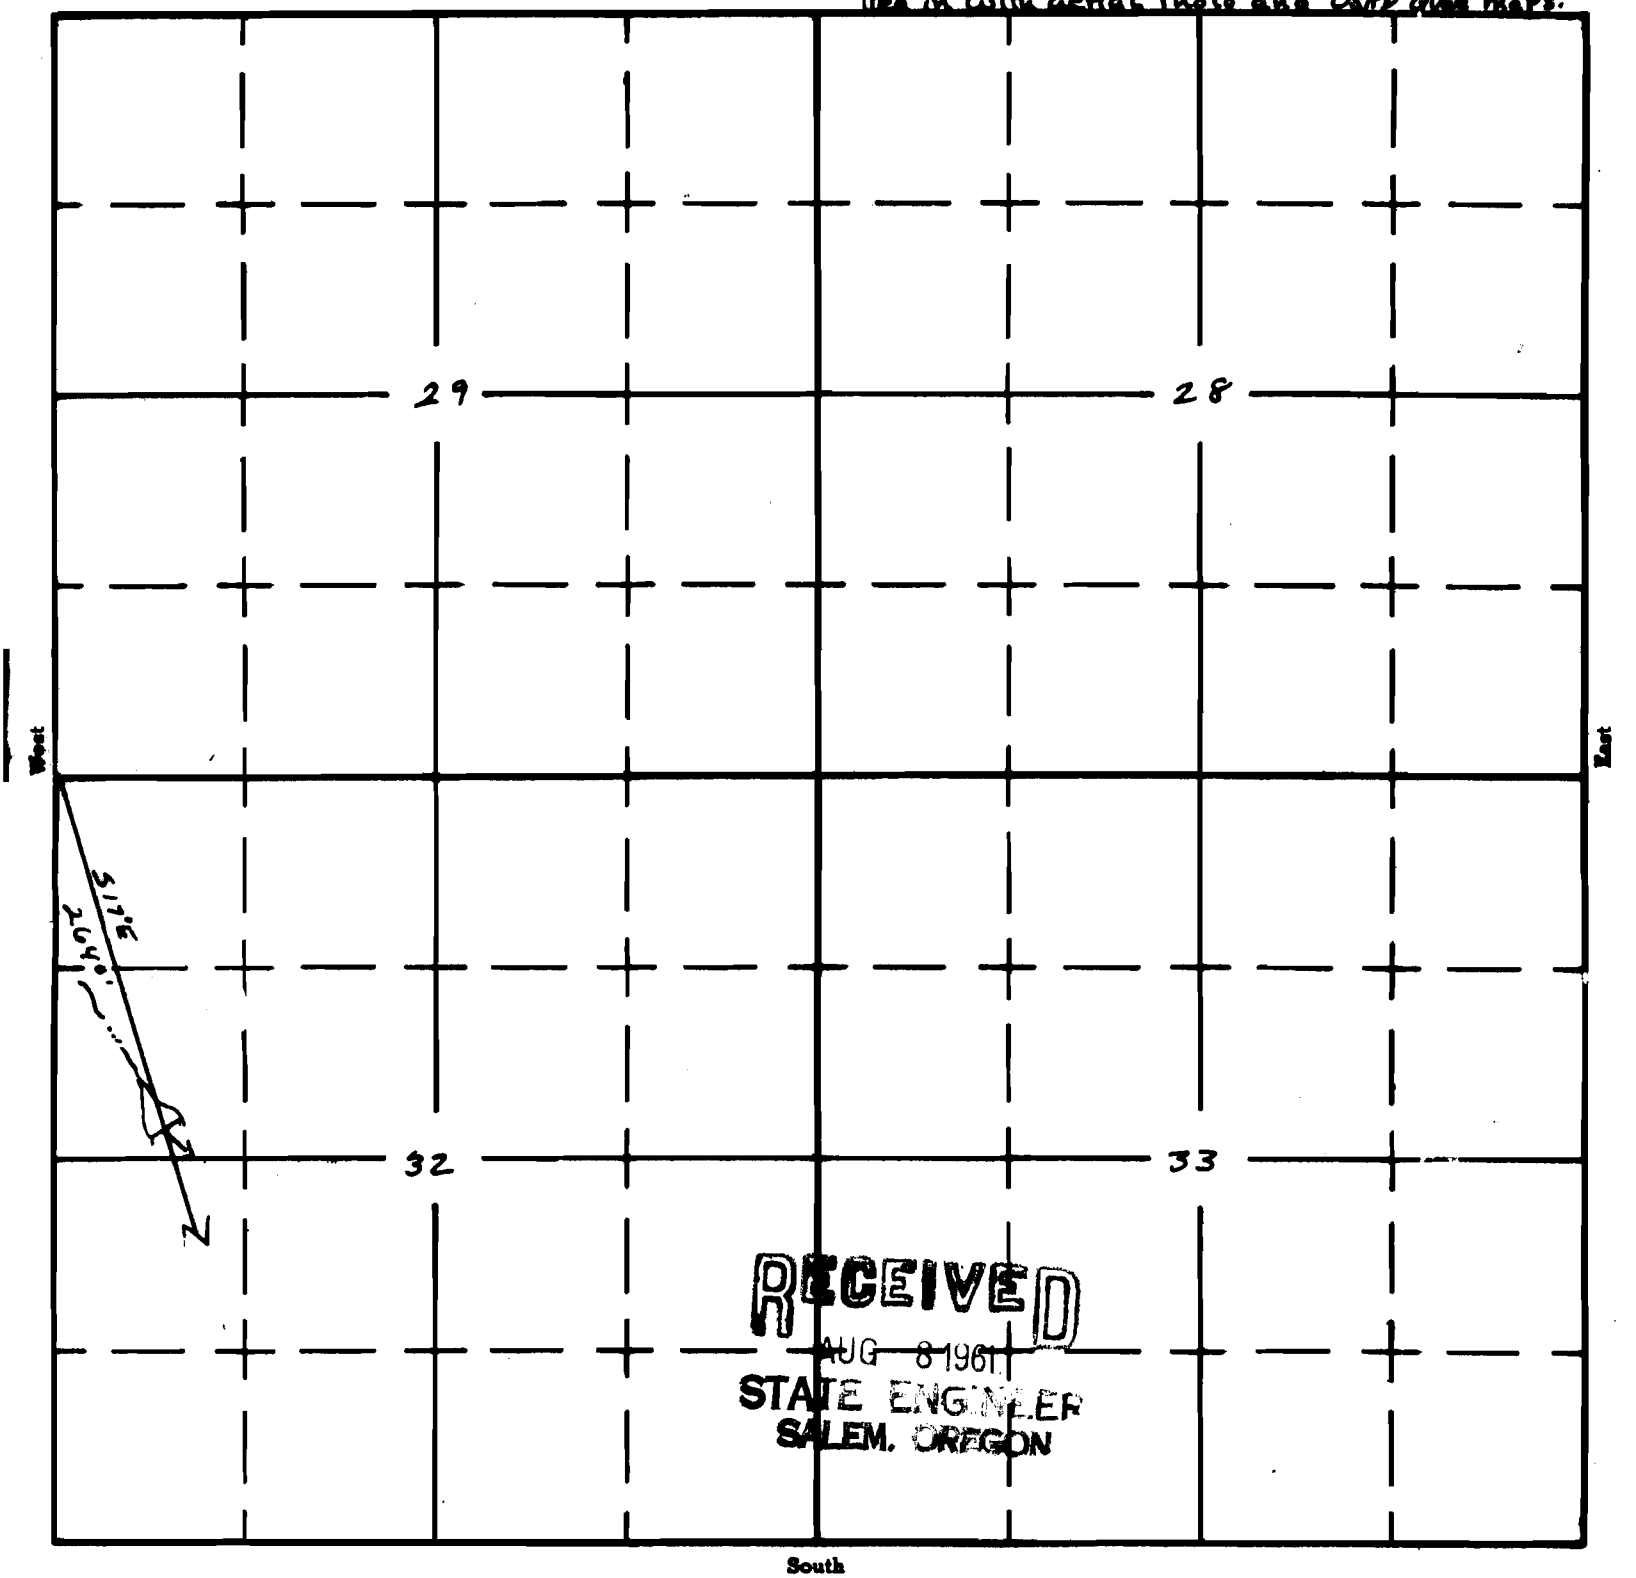

RECEIVED
AUG 8 1961
STATE ENGINEER
SALEM, OREGON

APPLICATION No. R-36340
PERMIT No. R 7095