

UNITED STATES
DEPARTMENT OF THE INTERIOR
BUREAU OF LAND MANAGEMENT

SECTION


24

Oregon State Water Filings

SE 1/4 NW 1/4

TOWNSHIP 37S, RANGE 23E, W. M.

Tied in with aerial photos - O.S.H.D. Quad Maps.

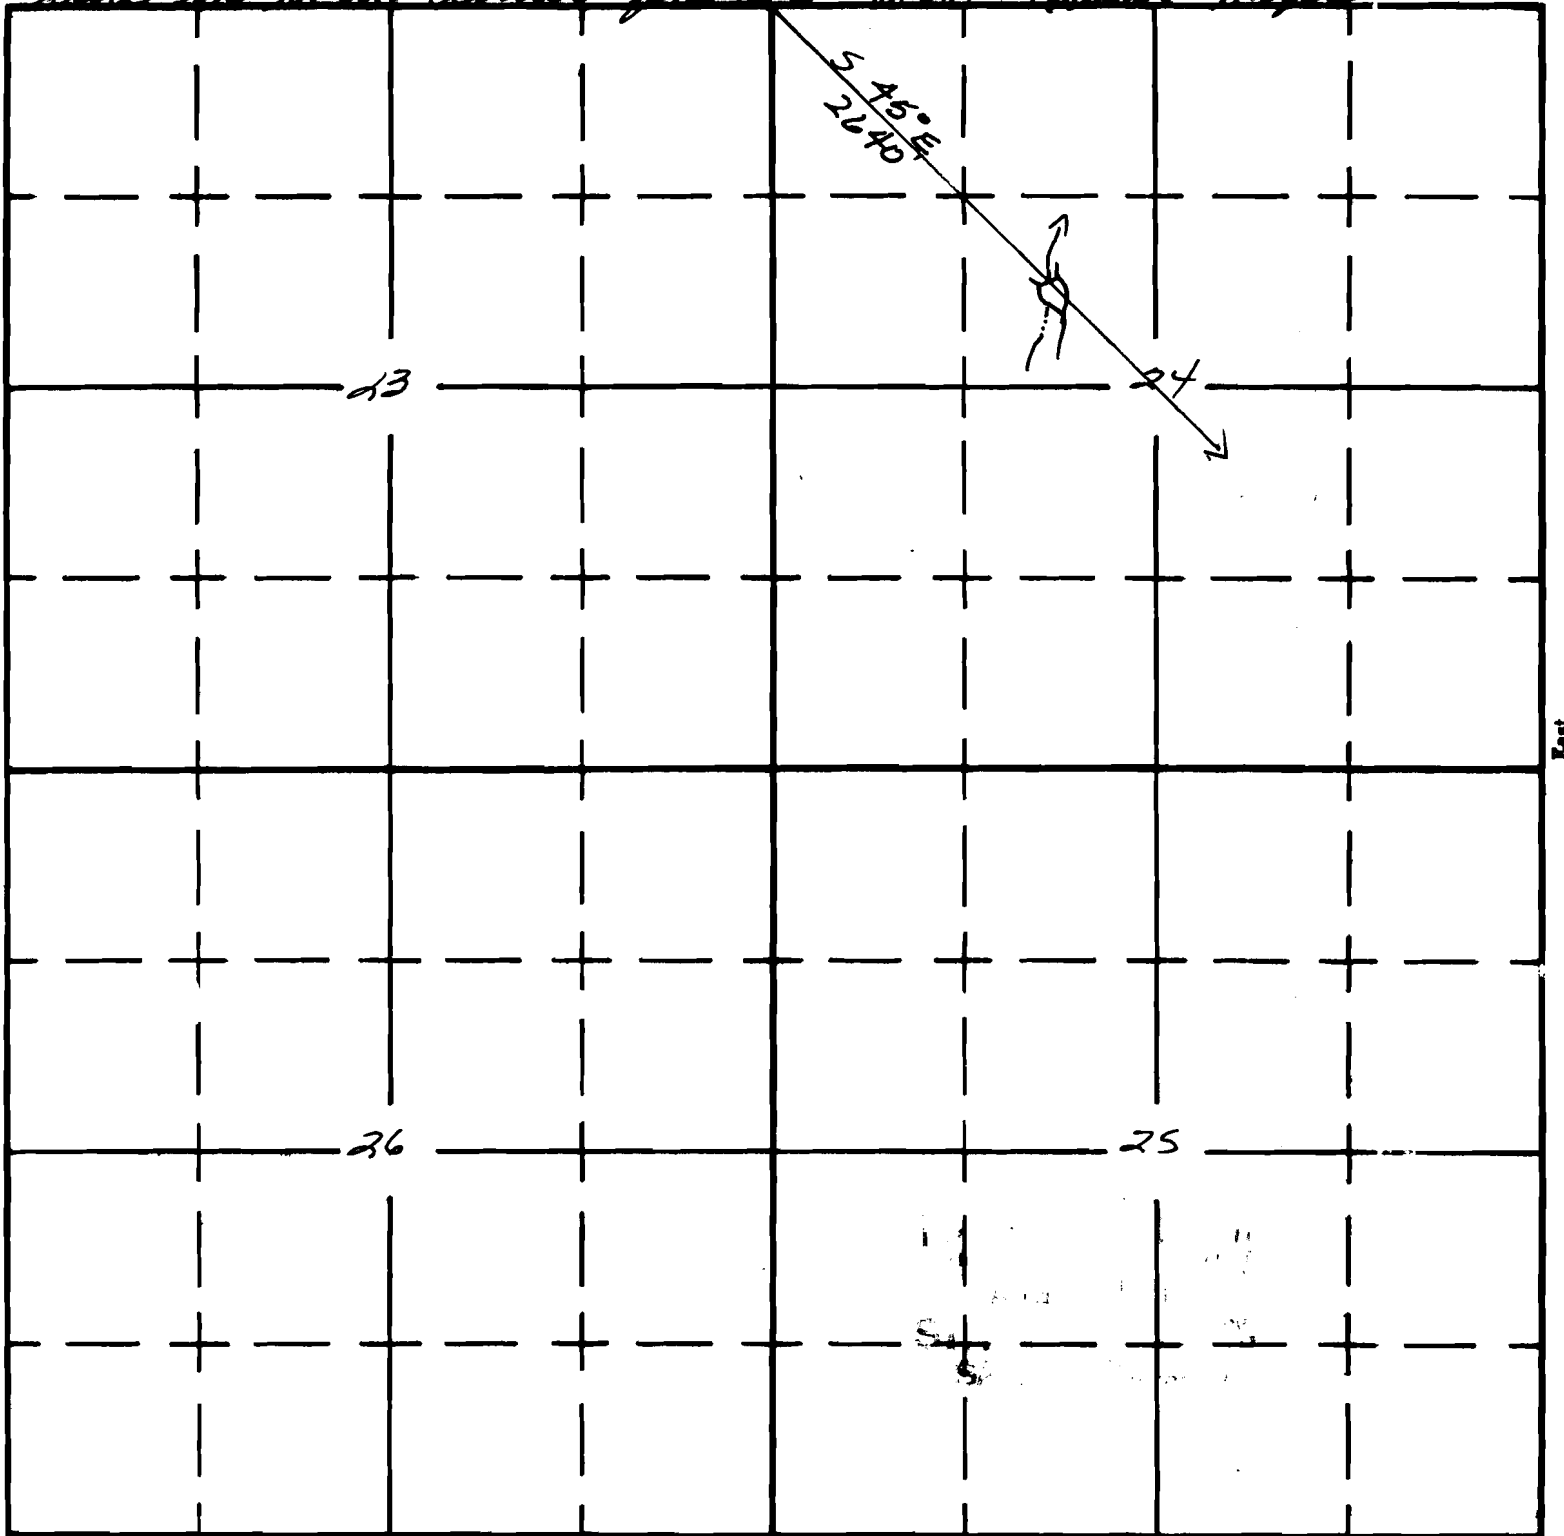

South

APPLICATION No. R-36424
PERMIT No. R 7152