

Form AI-187
March 1961

UNITED STATES
DEPARTMENT OF THE INTERIOR
BUREAU OF LAND MANAGEMENT

SECTION


22

SE 1/4 SE 1/4

Oregon State Water Filings

TOWNSHIP 35S, RANGE 22E, W. M.

North Tied in with aerial photo and OSN Quad Maps

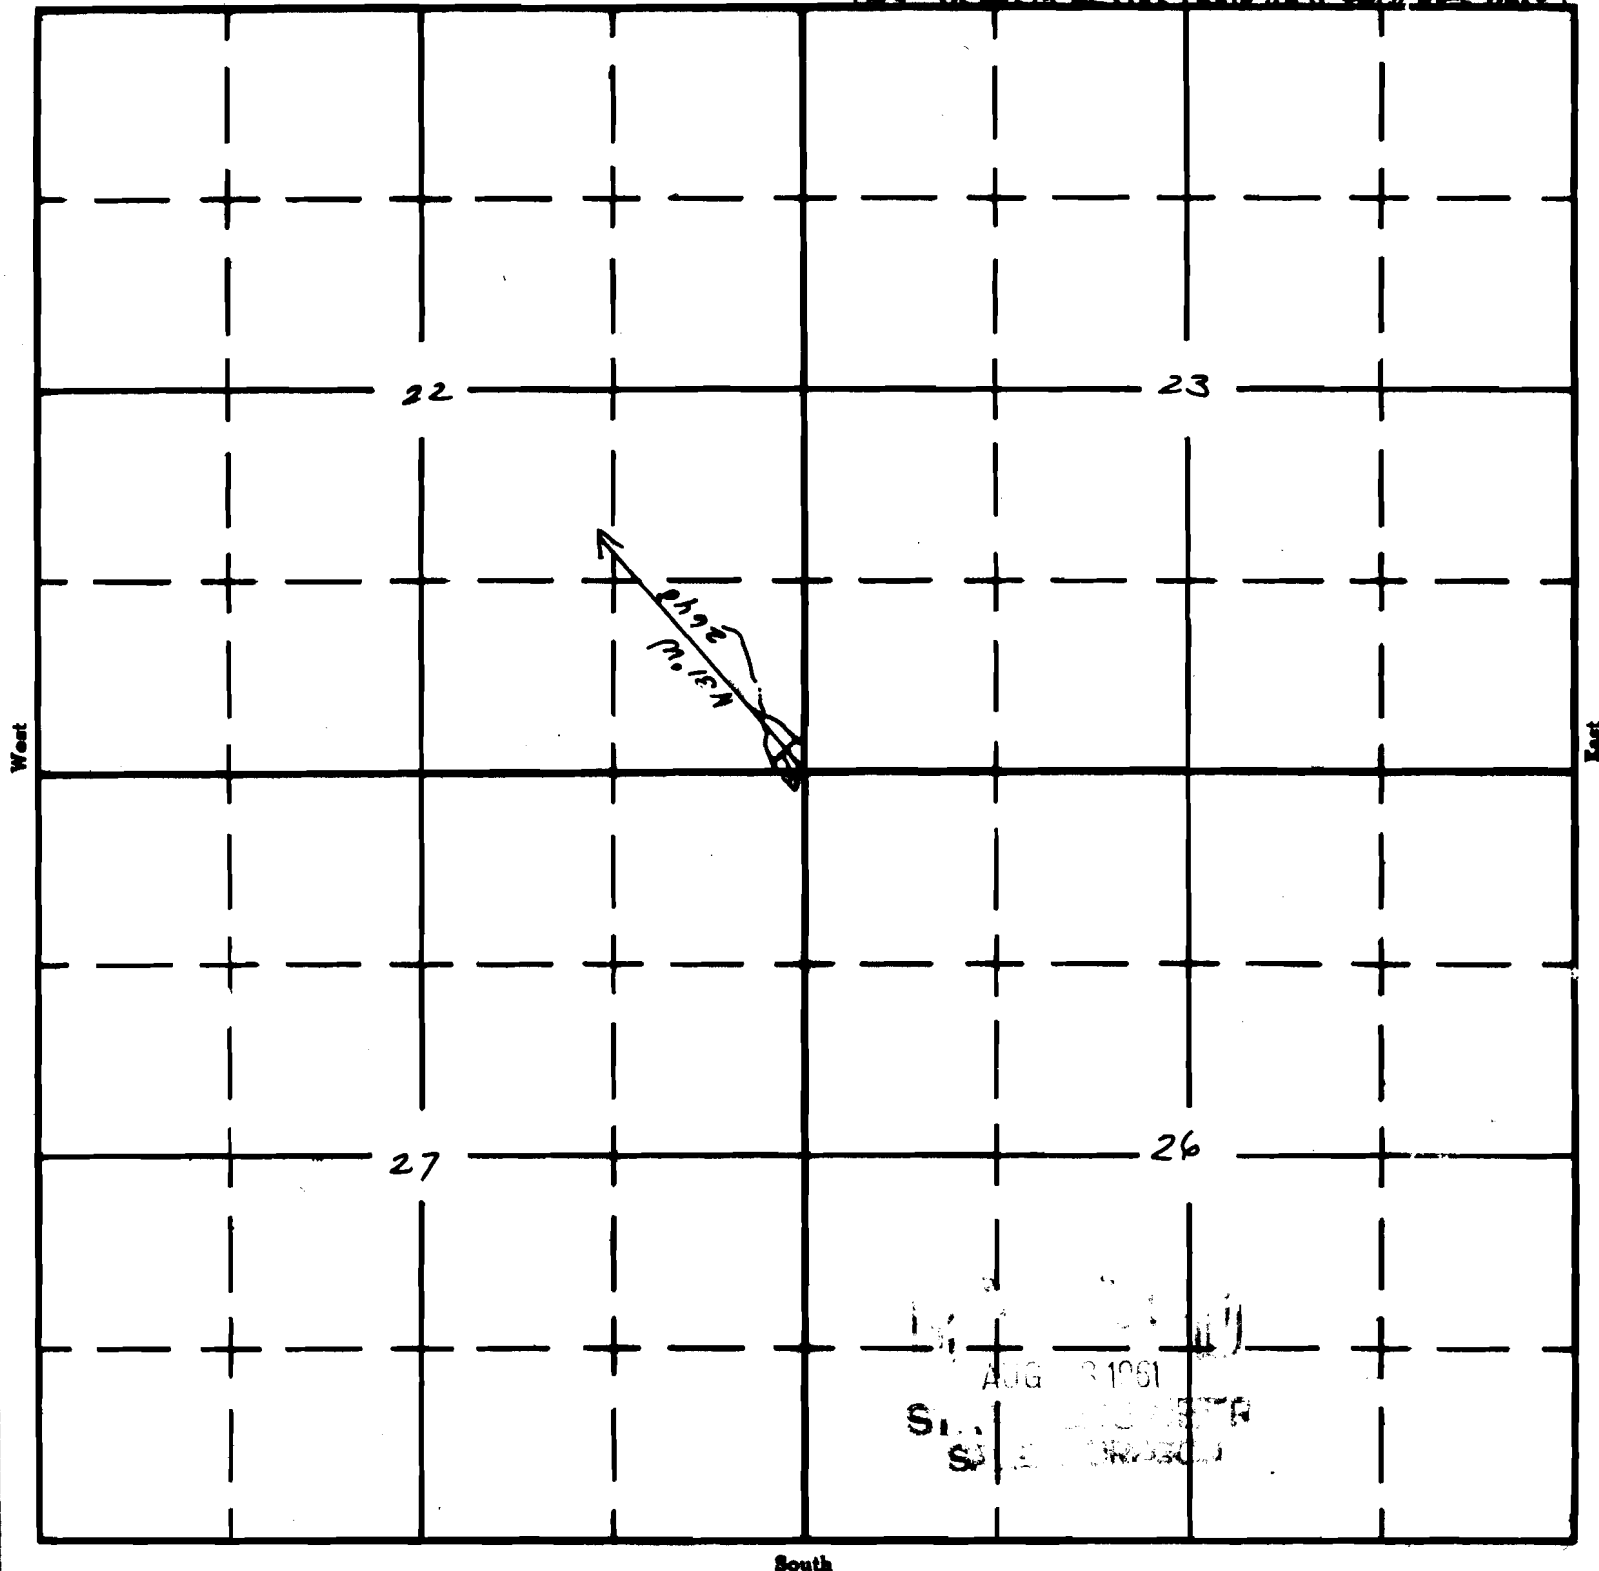

South

APPLICATION No. R-36442
PERMIT No. R 7168