

UNITED STATES
DEPARTMENT OF THE INTERIOR
BUREAU OF LAND MANAGEMENT

SECTION


17

SW 1/4 SE 1/4

Oregon State Water Filings

TOWNSHIP 35S, RANGE 22E, W. M.

North Tied in with aerial photo and OSHP Quad Maps

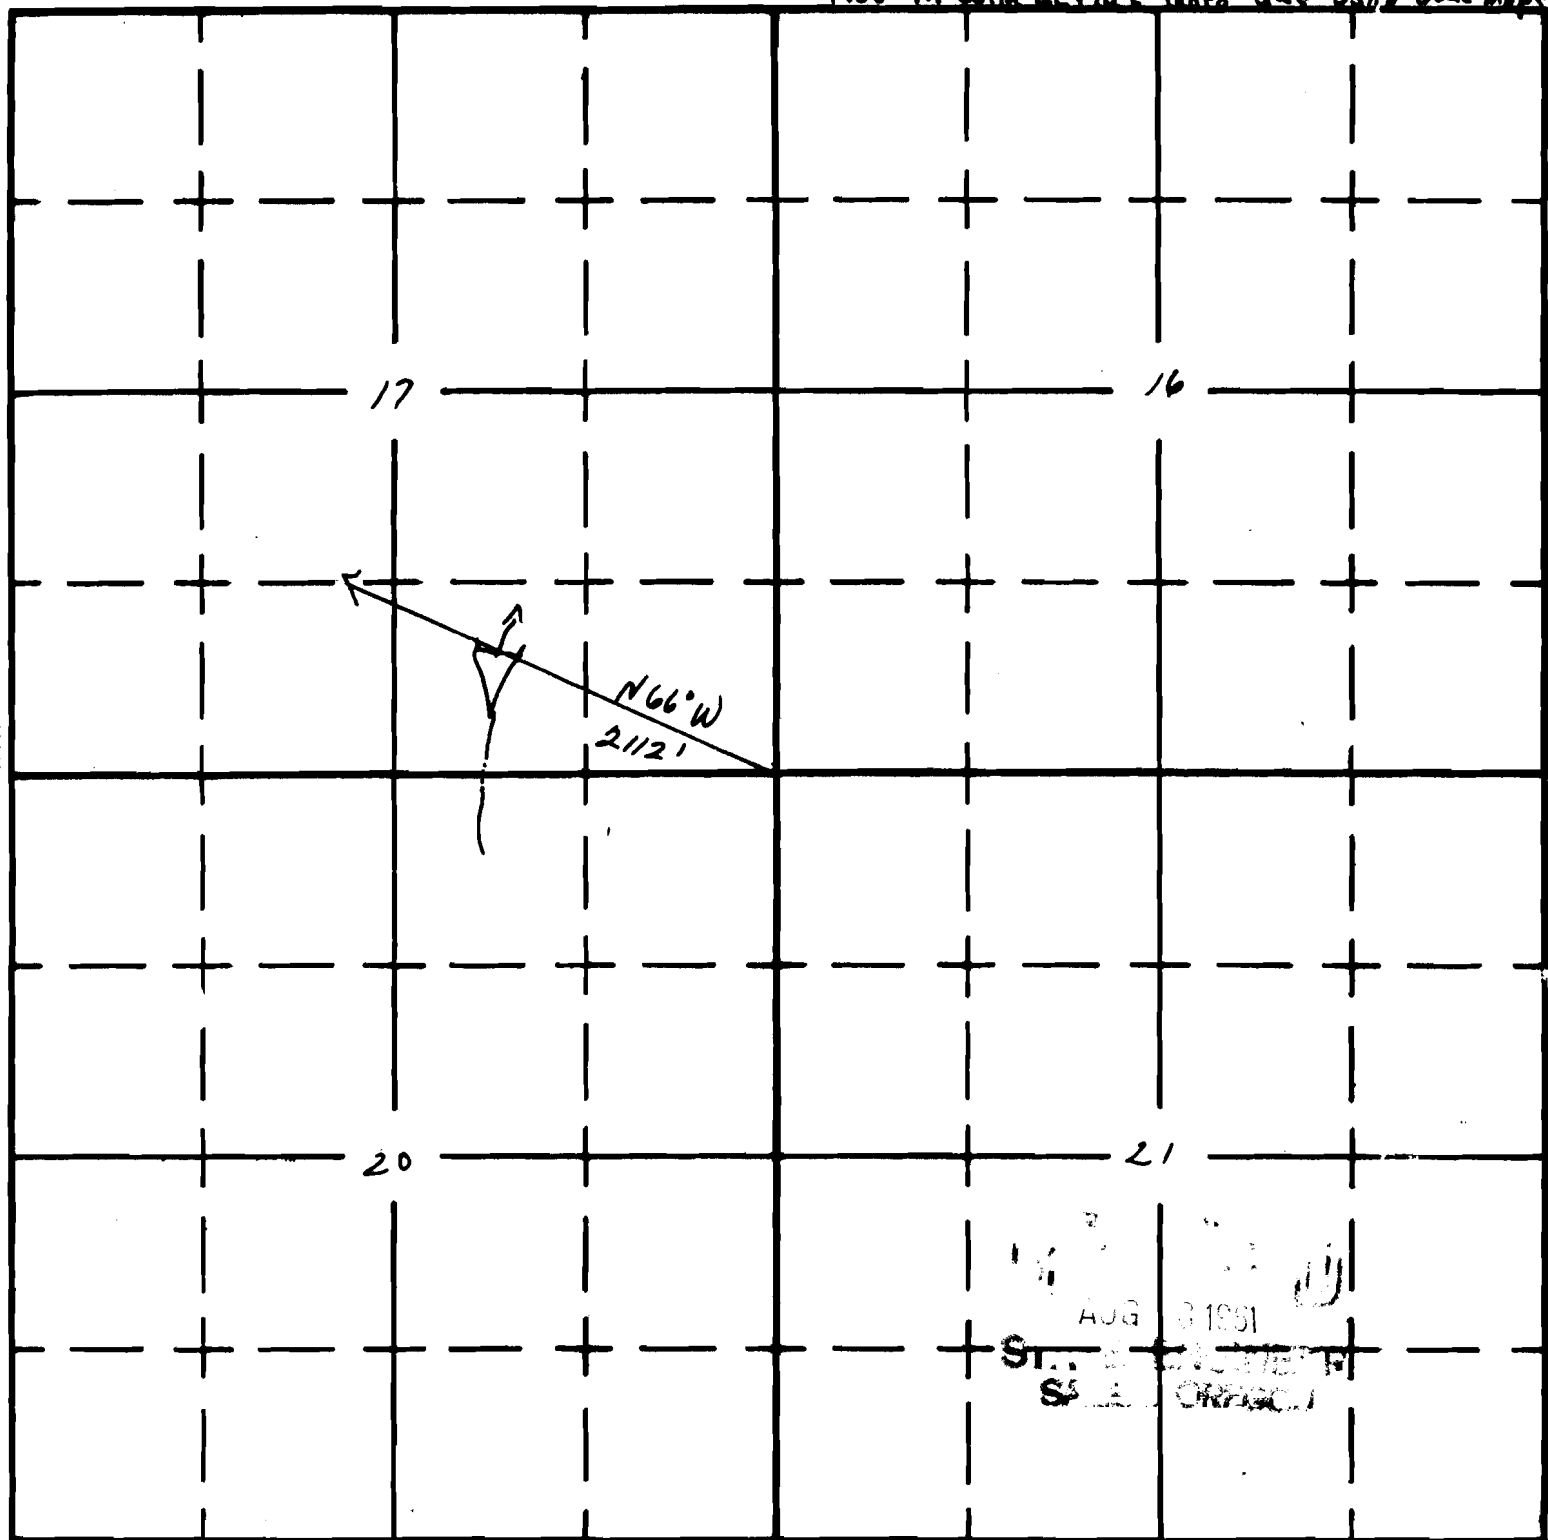

AUG 3 1961
ST. ...
S...

South

APPLICATION No. R-36445
PERMIT No. R 7170