

UNITED STATES
DEPARTMENT OF THE INTERIOR
BUREAU OF LAND MANAGEMENT

SECTION


7

NE 1/4 NW 1/4

Oregon State Water Filings

TOWNSHIP 35S, RANGE 23E, W. M.

North Tied in with aerial photo and OSND Quad Map

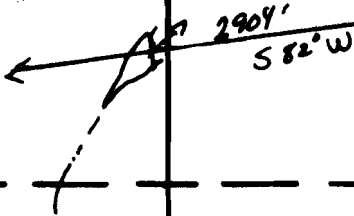

Application No. R 36472
Permit No. R 7722

RECEIVED

AUG 8 1961
STATE ENGINEER
SALEM, OREGON

DEC 10 1961

South

APPLICATION No.
PERMIT No.