

Form A1-187
March 1961

UNITED STATES
DEPARTMENT OF THE INTERIOR
BUREAU OF LAND MANAGEMENT

R-7371

SECTION

NW 1/4

SEC. 18


Oregon State Water Filings

JAN 17 1963

TOWNSHIP 39-S, RANGE 26-E, W. M.

67414

North

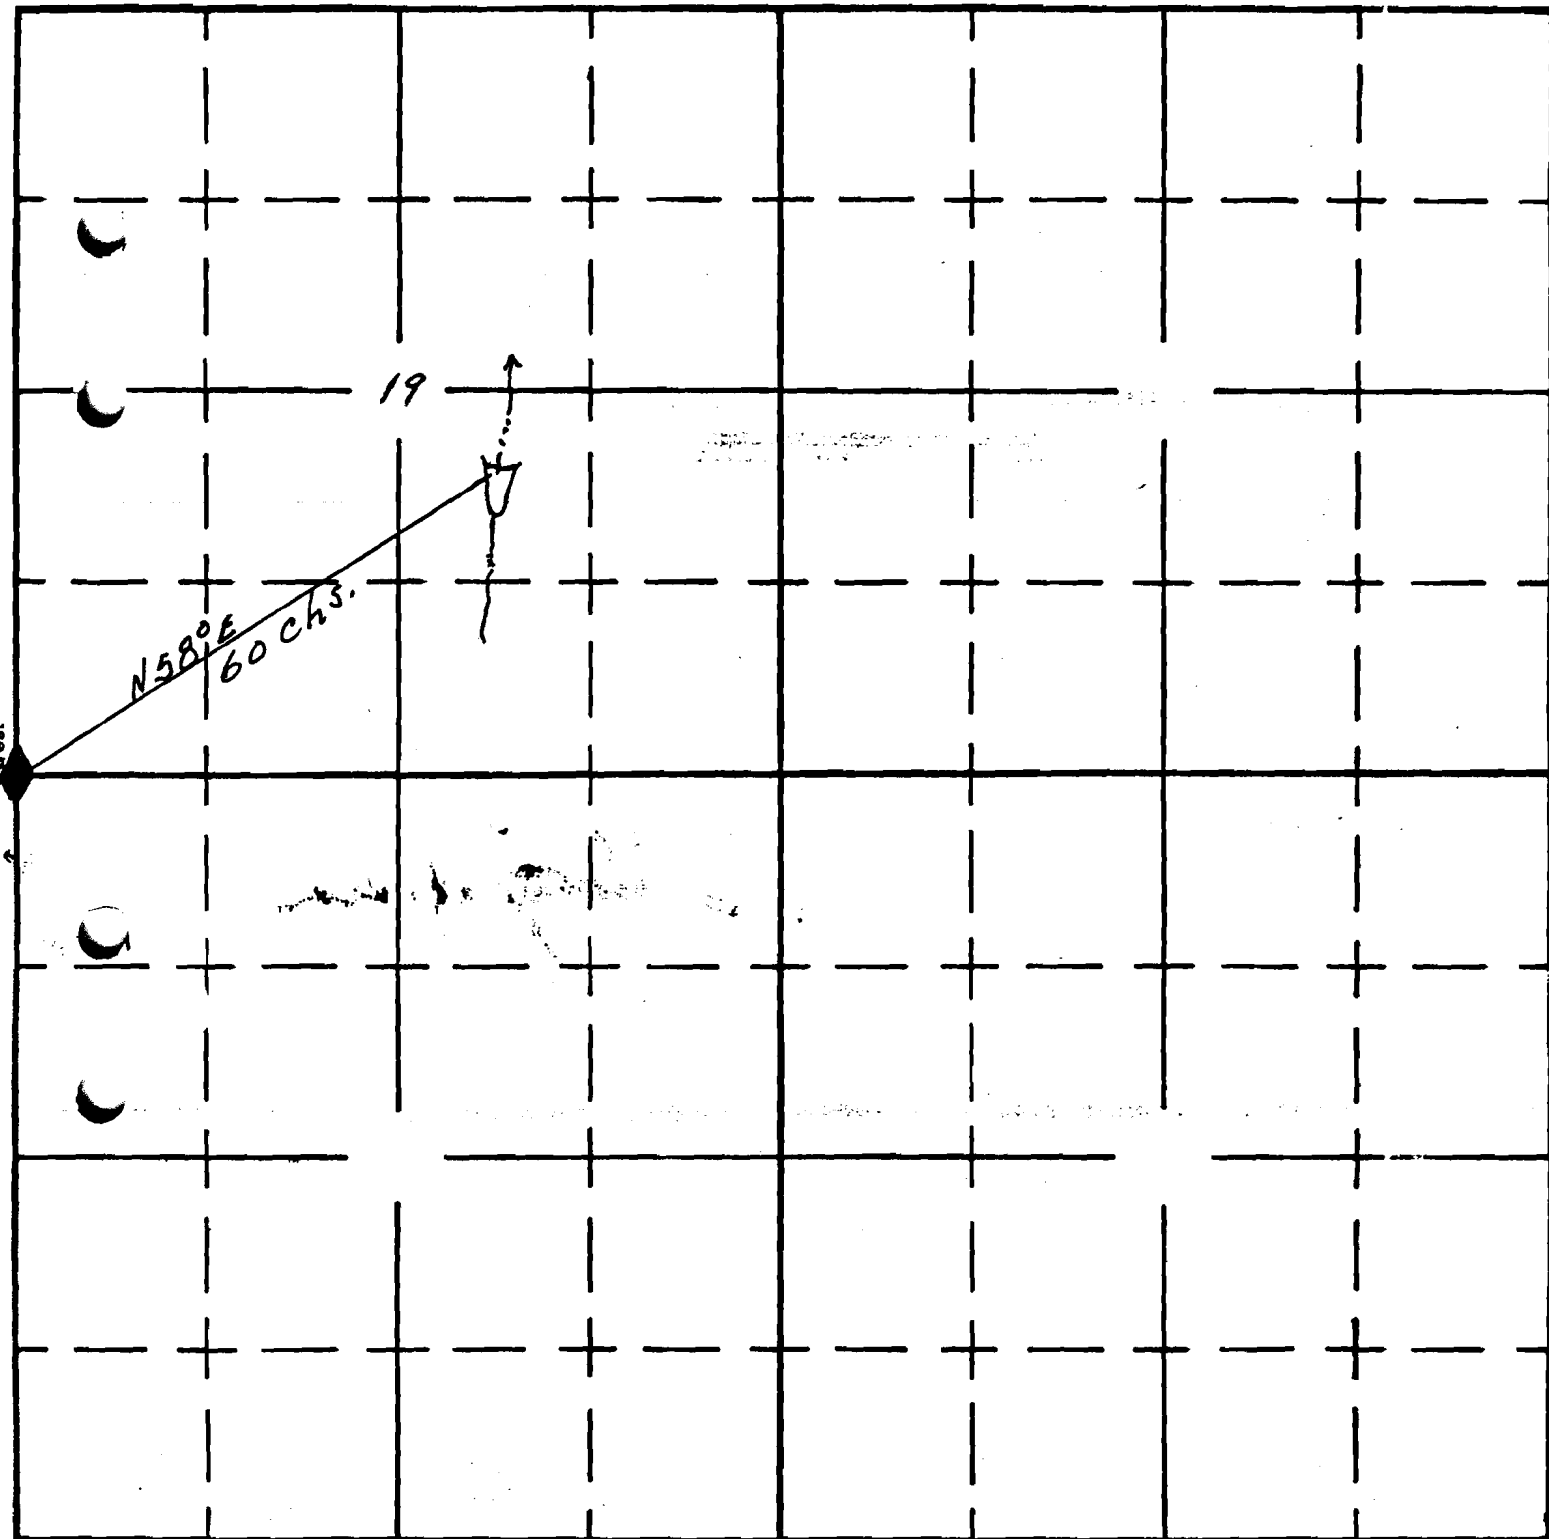

South

APPLICATION No. R-39360
PERMIT No. R-7371