

March 1961

UNITED STATES

DEPARTMENT OF THE INTERIOR

BUREAU OF LAND MANAGEMENT

R-7372

RECEIVED
JAN 17 1963


SECTION

Oregon State Water Filings

TOWNSHIP 39-S, RANGE 26-E, W. M.WILLIAM GREEN
LAND OREGON

67415

North

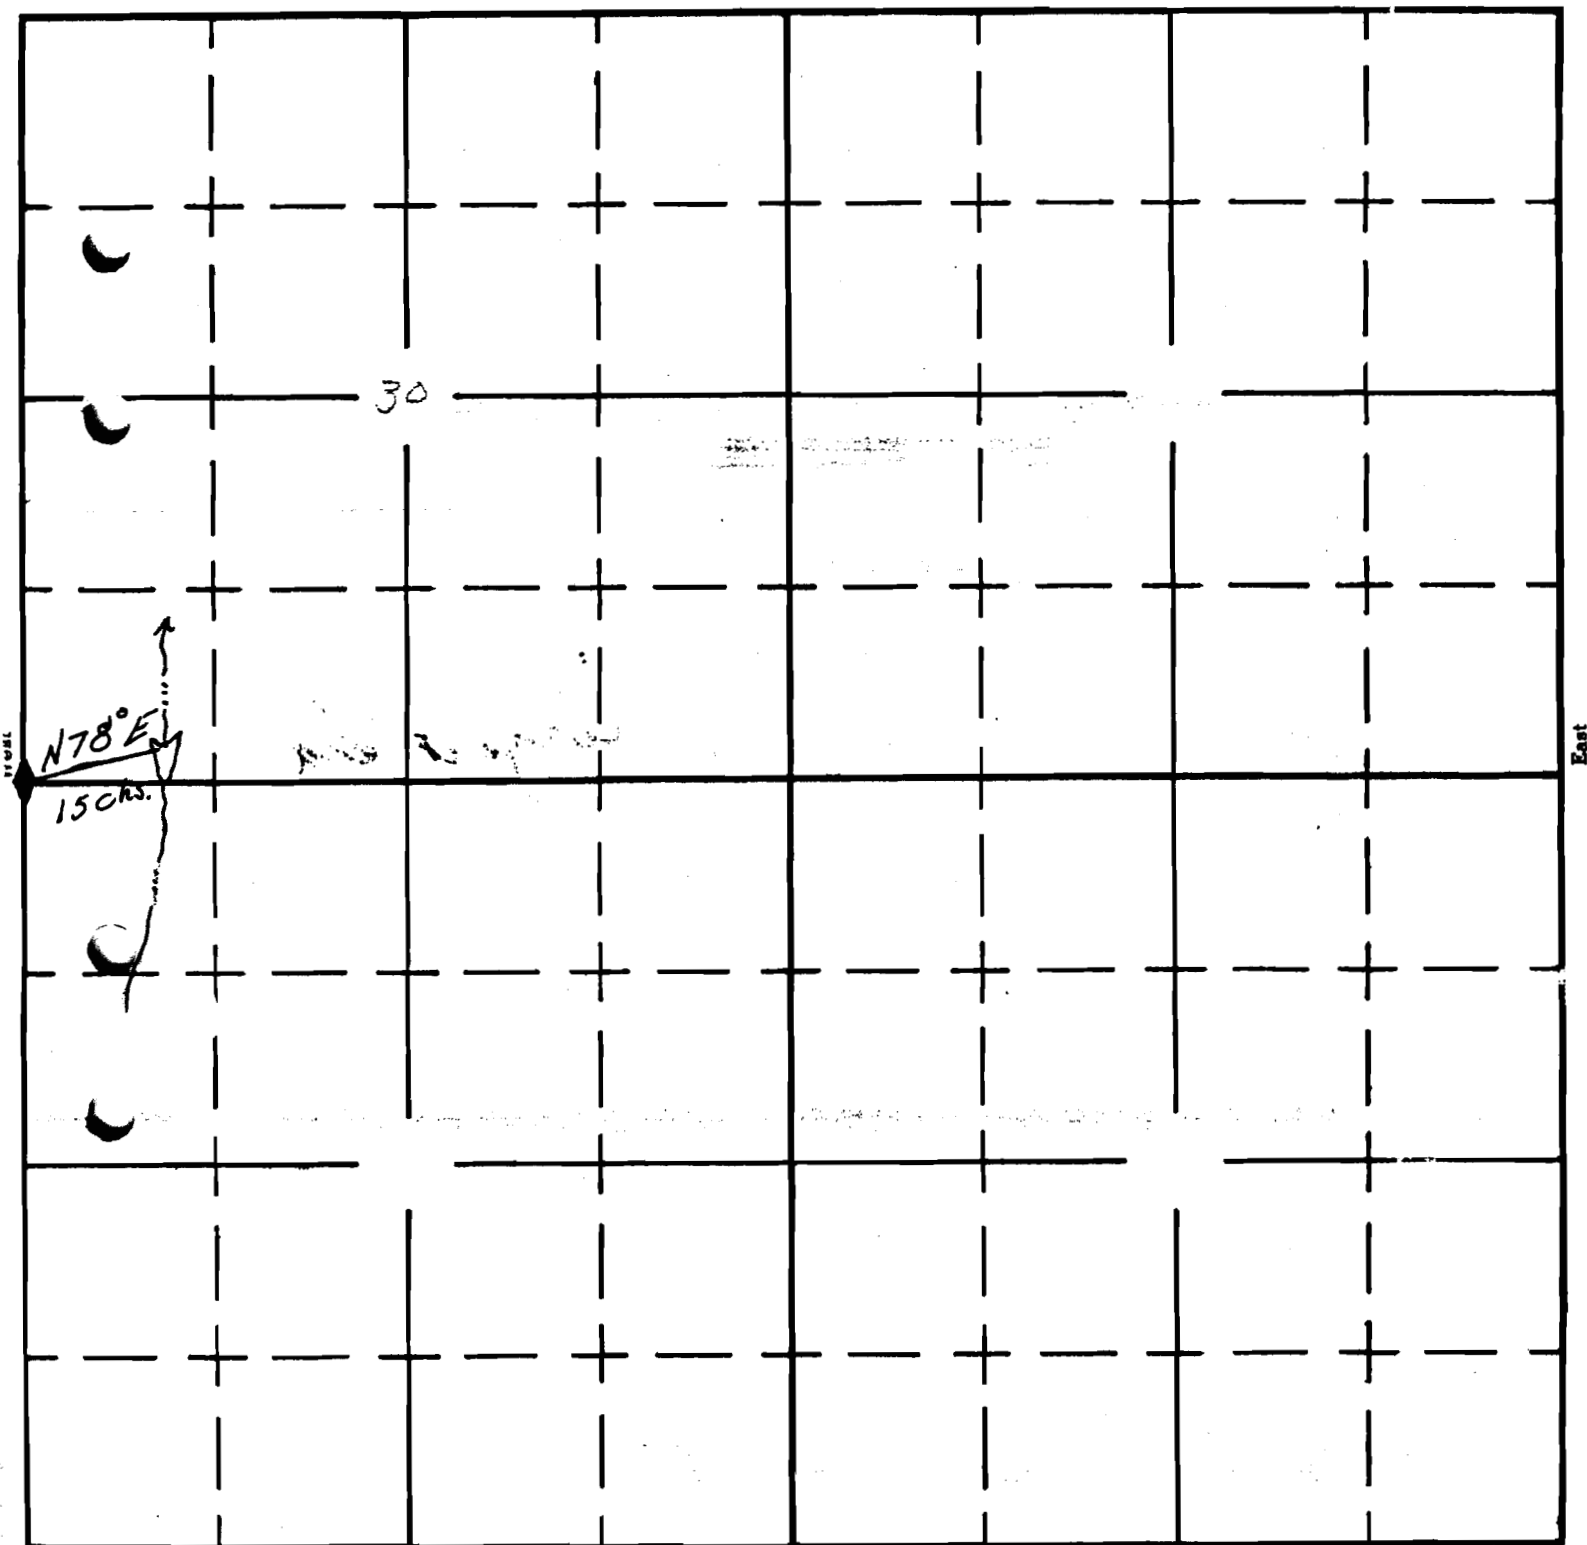

South

APPLICATION No. A-38361
PERMIT NO. R 7372