

Form AI-187
March 1961

UNITED STATES
DEPARTMENT OF THE INTERIOR
BUREAU OF LAND MANAGEMENT

R-7726

67416


SECTION

29

Oregon State Water Filings

SE 1/4 SW 1/4

TOWNSHIP 39S, RANGE 26E, W. M.

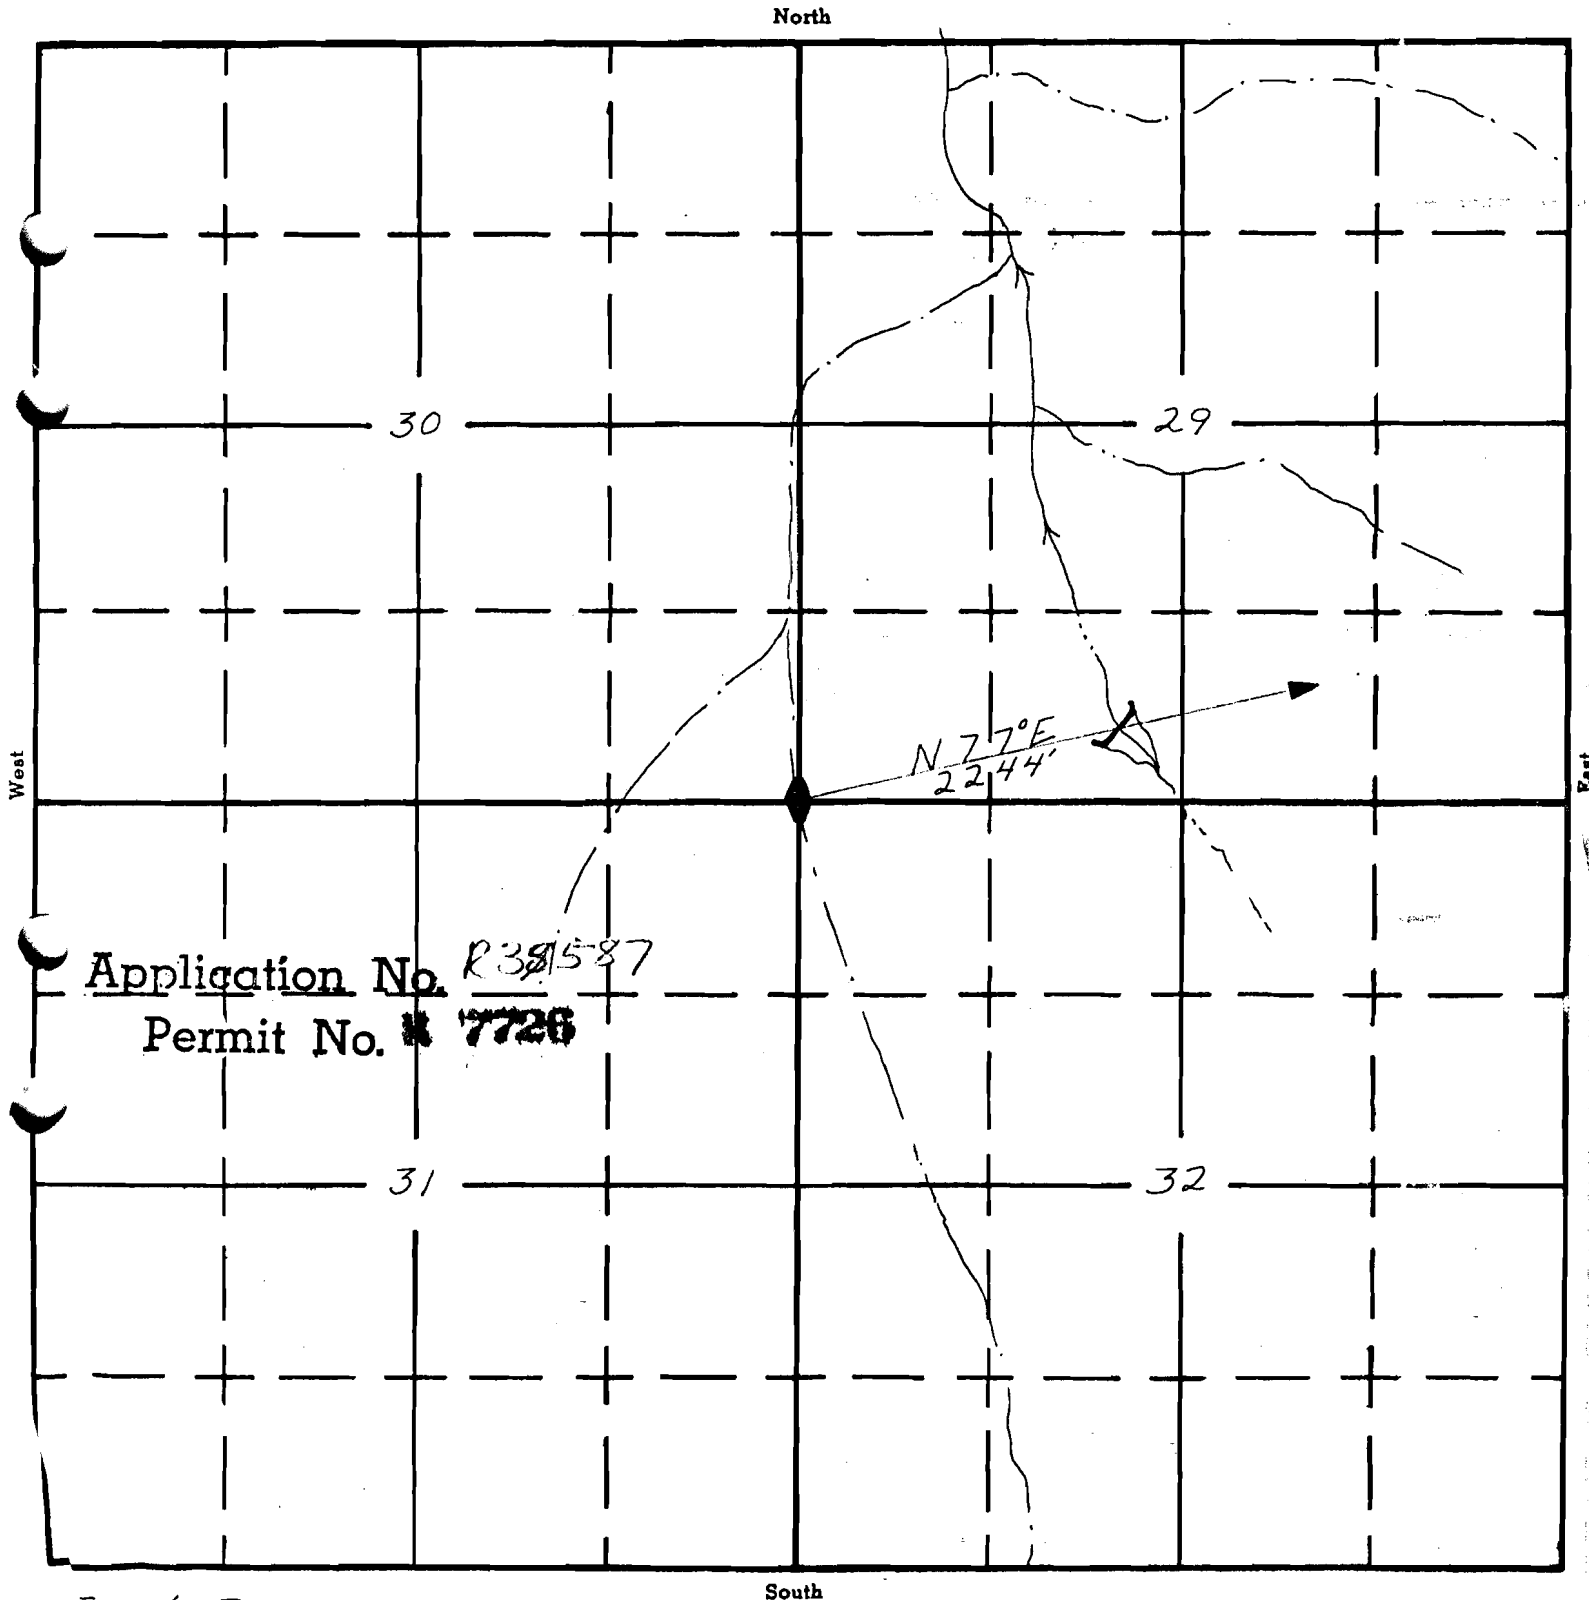

Application No. R-38587

Permit No. R-7726

trial Reservoir
U-R-238

APPLICATION No. R-38587
PERMIT No.


UNITED STATES
DEPARTMENT OF THE INTERIOR
BUREAU OF LAND MANAGEMENT

SECTION 29

Oregon State Water Filings

SE 1/4 SW 1/4

TOWNSHIP 39S, RANGE 26E, W. M.

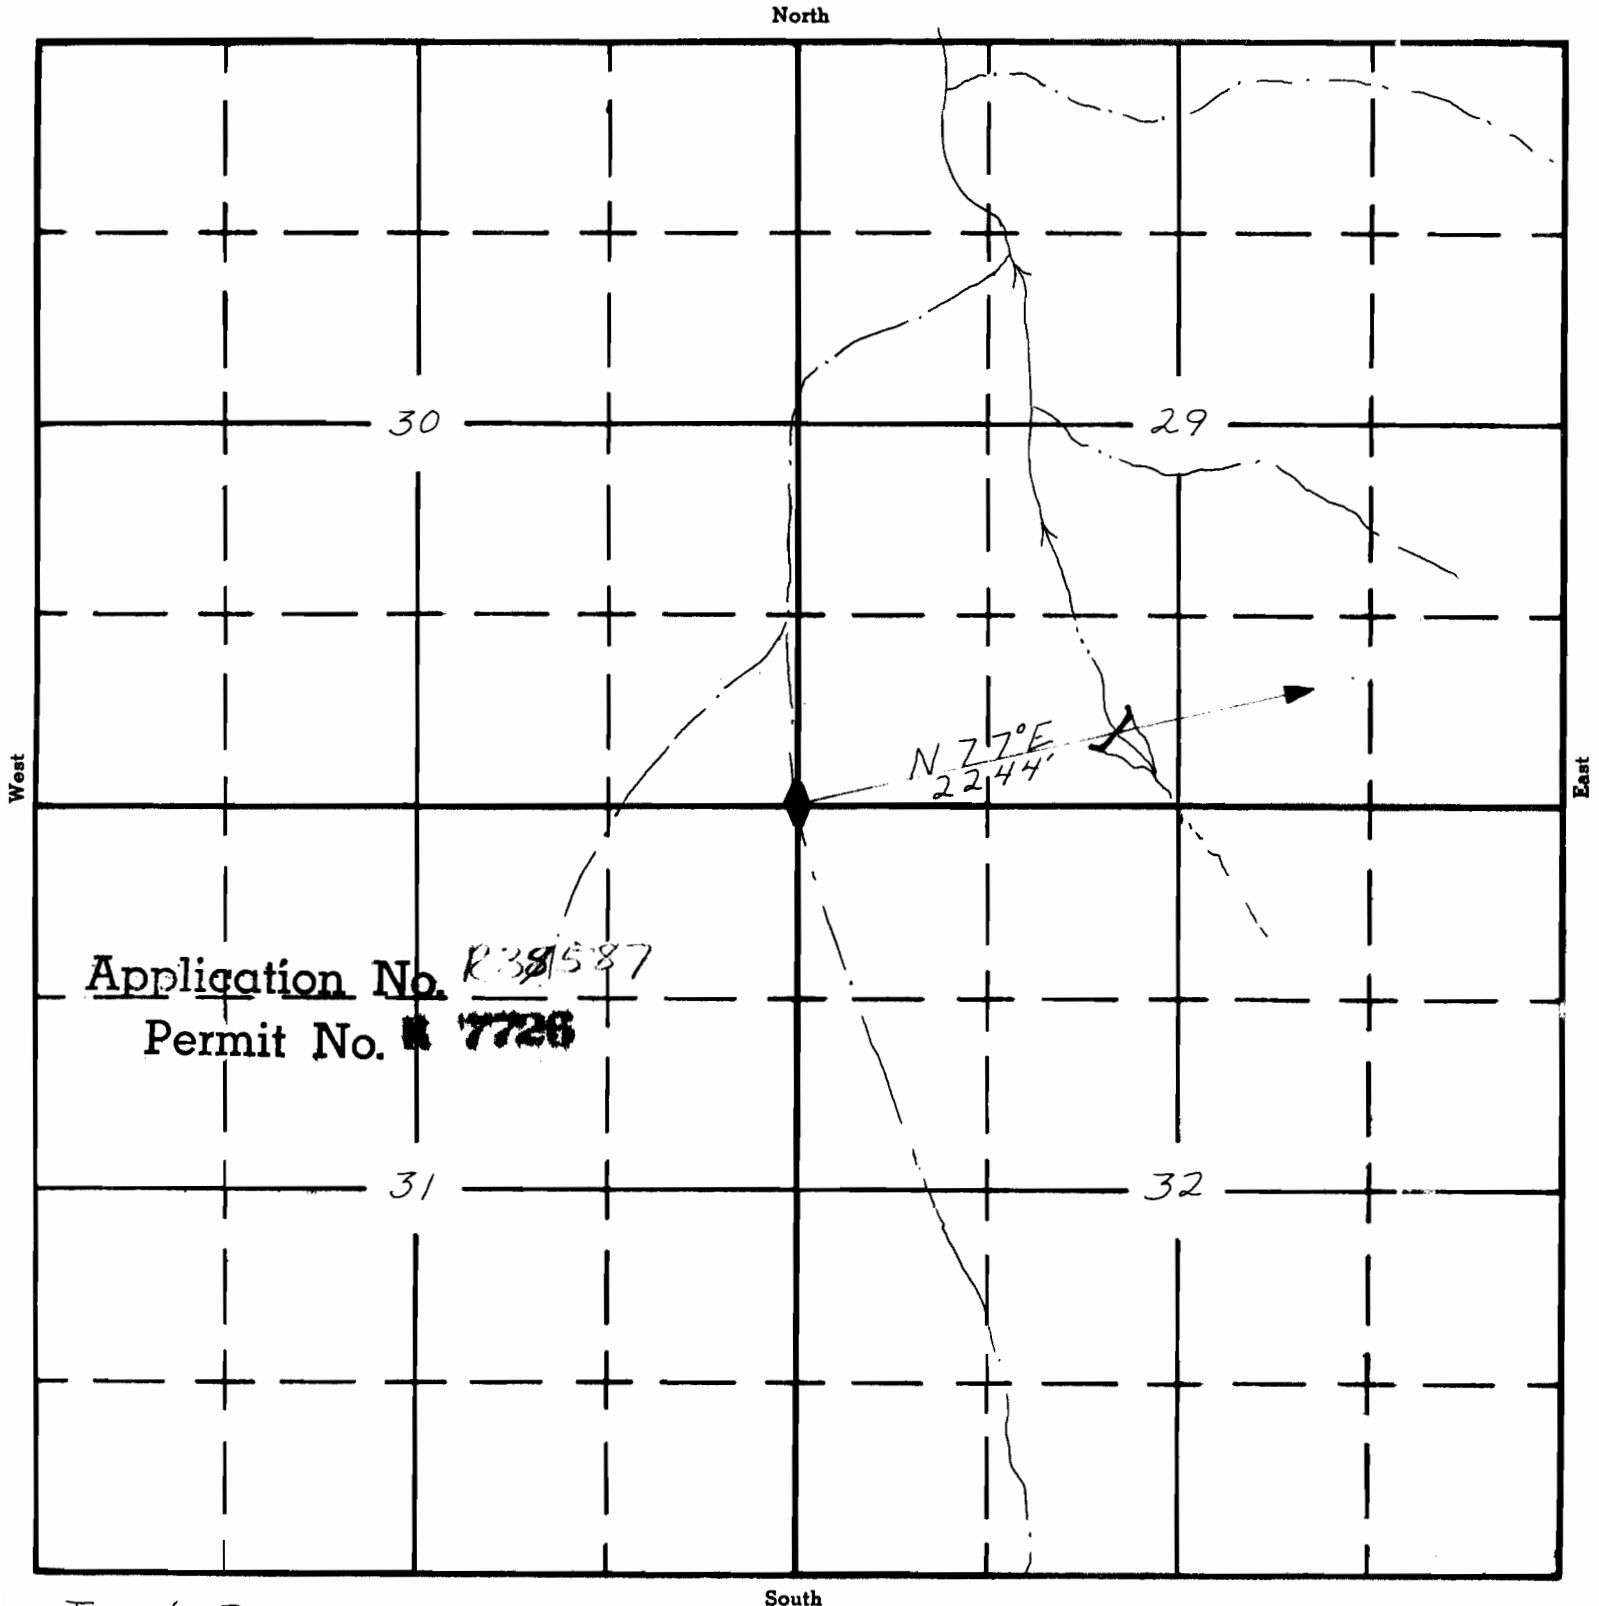

Trial Reservoir
01-R-238

APPLICATION No. R-38587
PERMIT No.