

R-7373

Form AI-187

March 1961

UNITED STATES

DEPARTMENT OF THE INTERIOR

BUREAU OF LAND MANAGEMENT

SECTION

19

Oregon State Water Filings

NE 1/4 NW 1/4


TOWNSHIP 40S, RANGE 26E, W. M.

STATE ENGINEER
DAVID OLSON

67417

APR 5 1963

North

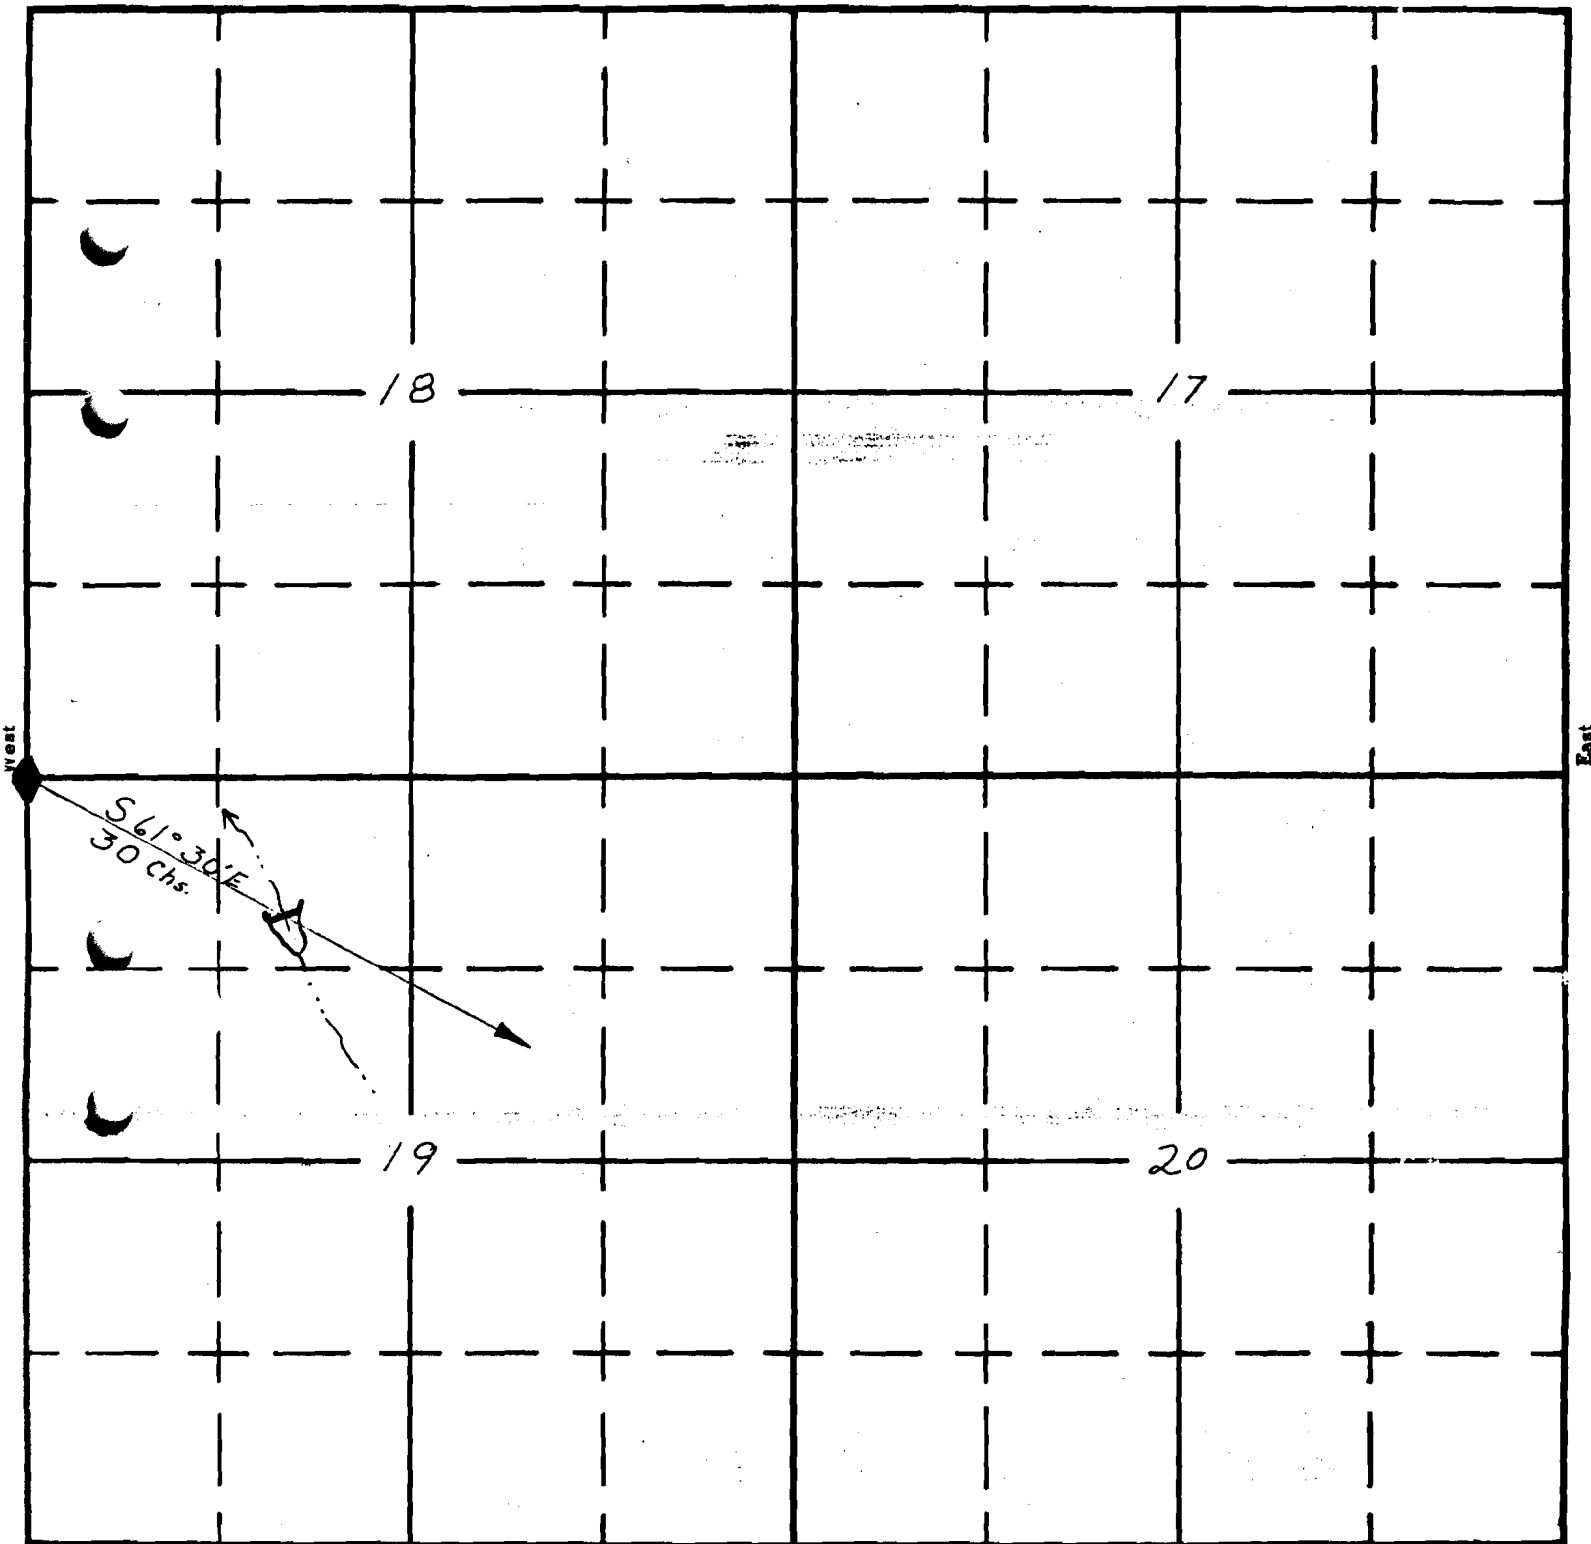

LSH Reservoir

01-R-250

South

APPLICATION No. R-38594
PERMIT No. R-7373