

UNITED STATES
DEPARTMENT OF THE INTERIOR
BUREAU OF LAND MANAGEMENT

R-7727
67418
74513


SECTION 4

Oregon State Water Filings

NW 1/4 SE 1/4
NW 1/4

TOWNSHIP 41S, RANGE 24E, W. M.

STATE ENGINEER
JULY 1961

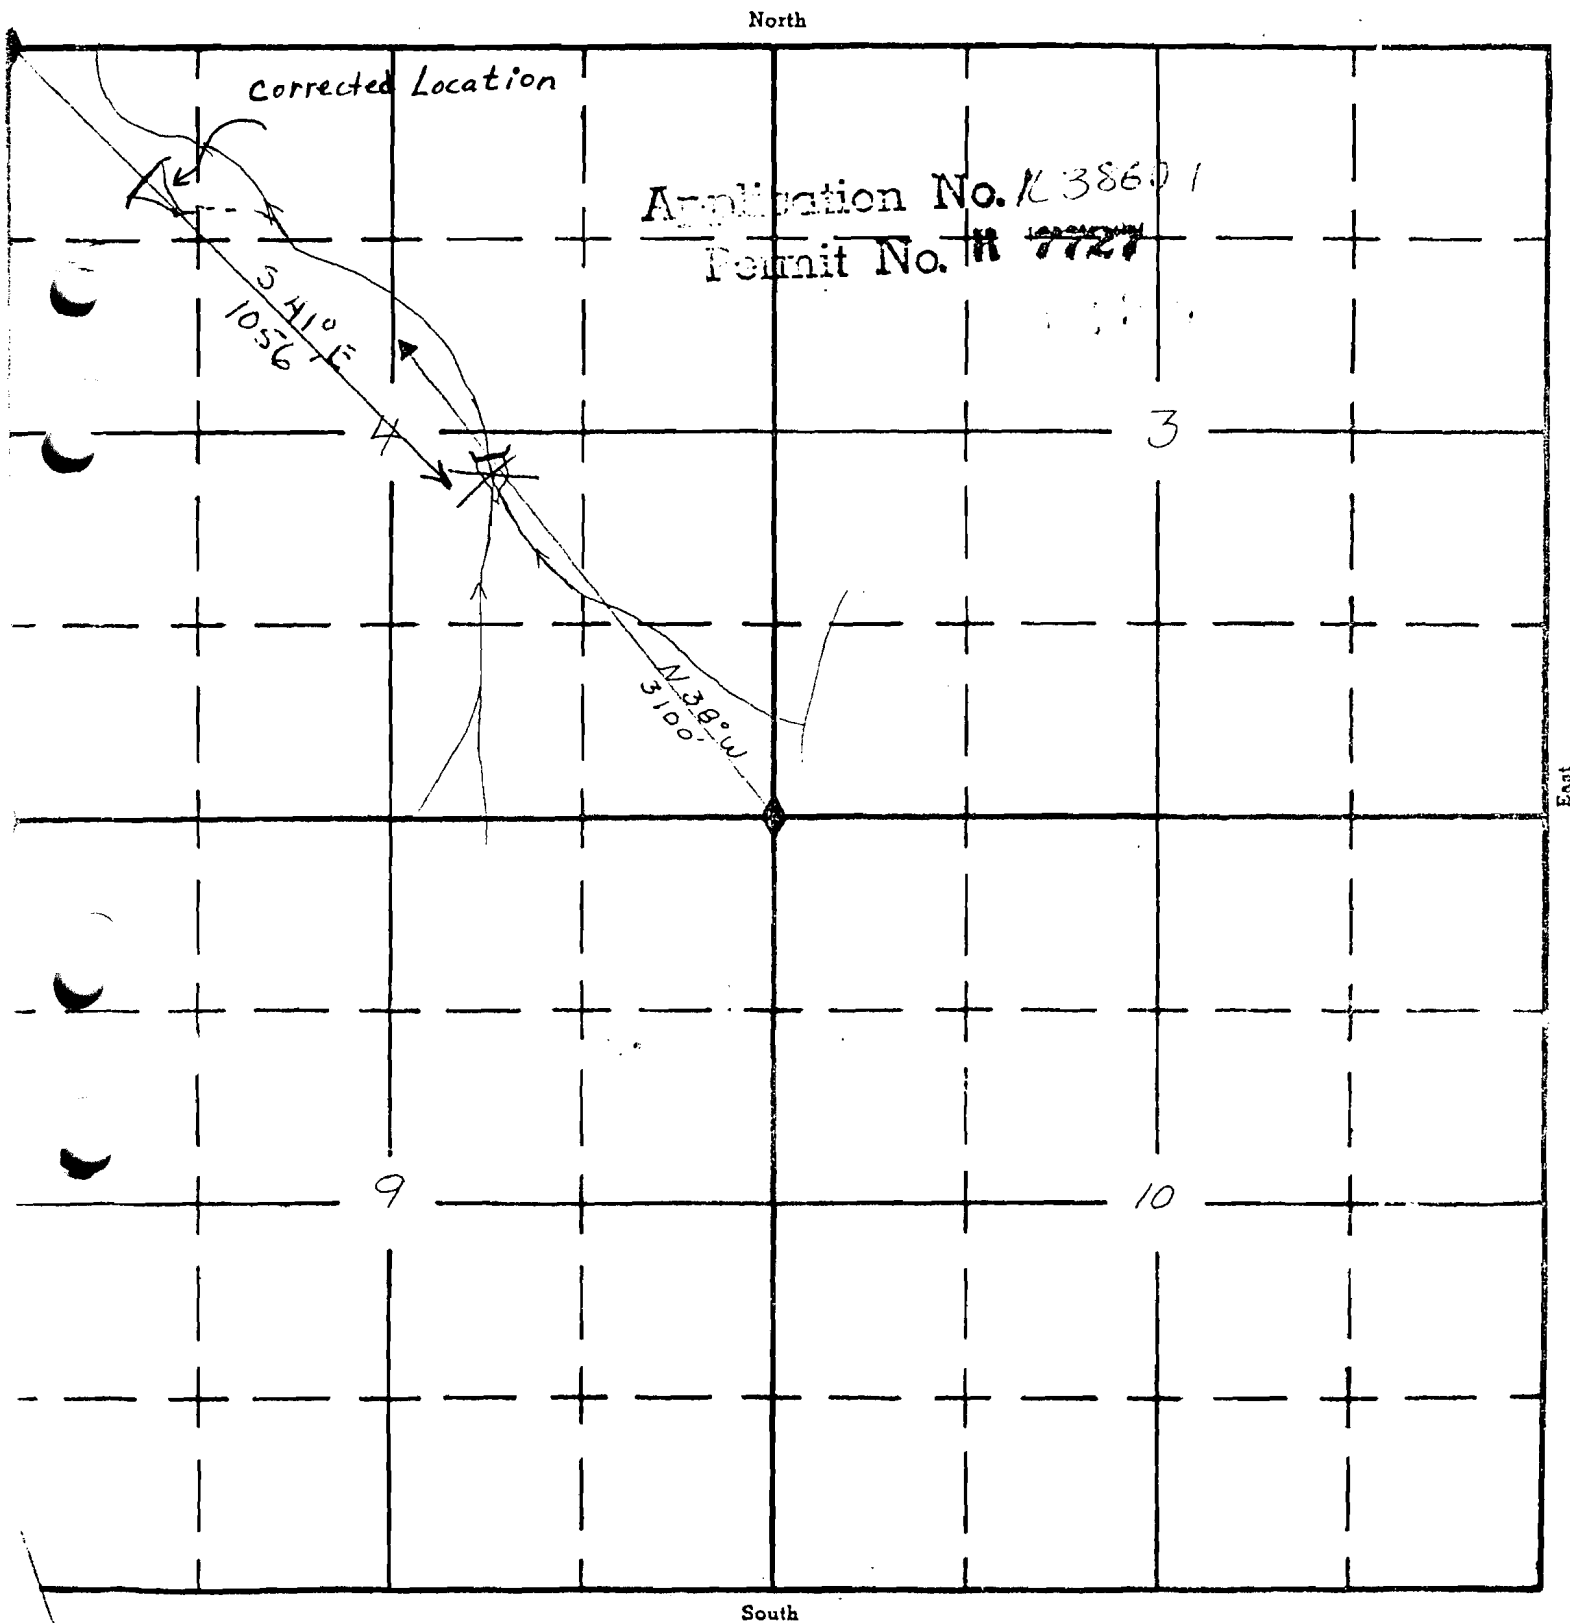

C. Res. #28

APPLICATION No. R-38601
PERMIT No.