

R 7354

Form A1-187

March 1961

UNITED STATES
DEPARTMENT OF THE INTERIOR
BUREAU OF LAND MANAGEMENT

SECTION


Oregon State Water Filings

67420

SW 1/4, NW 1/4
Sec. 26

TOWNSHIP T. 38 S., RANGE R. 23 E., W. M.

North

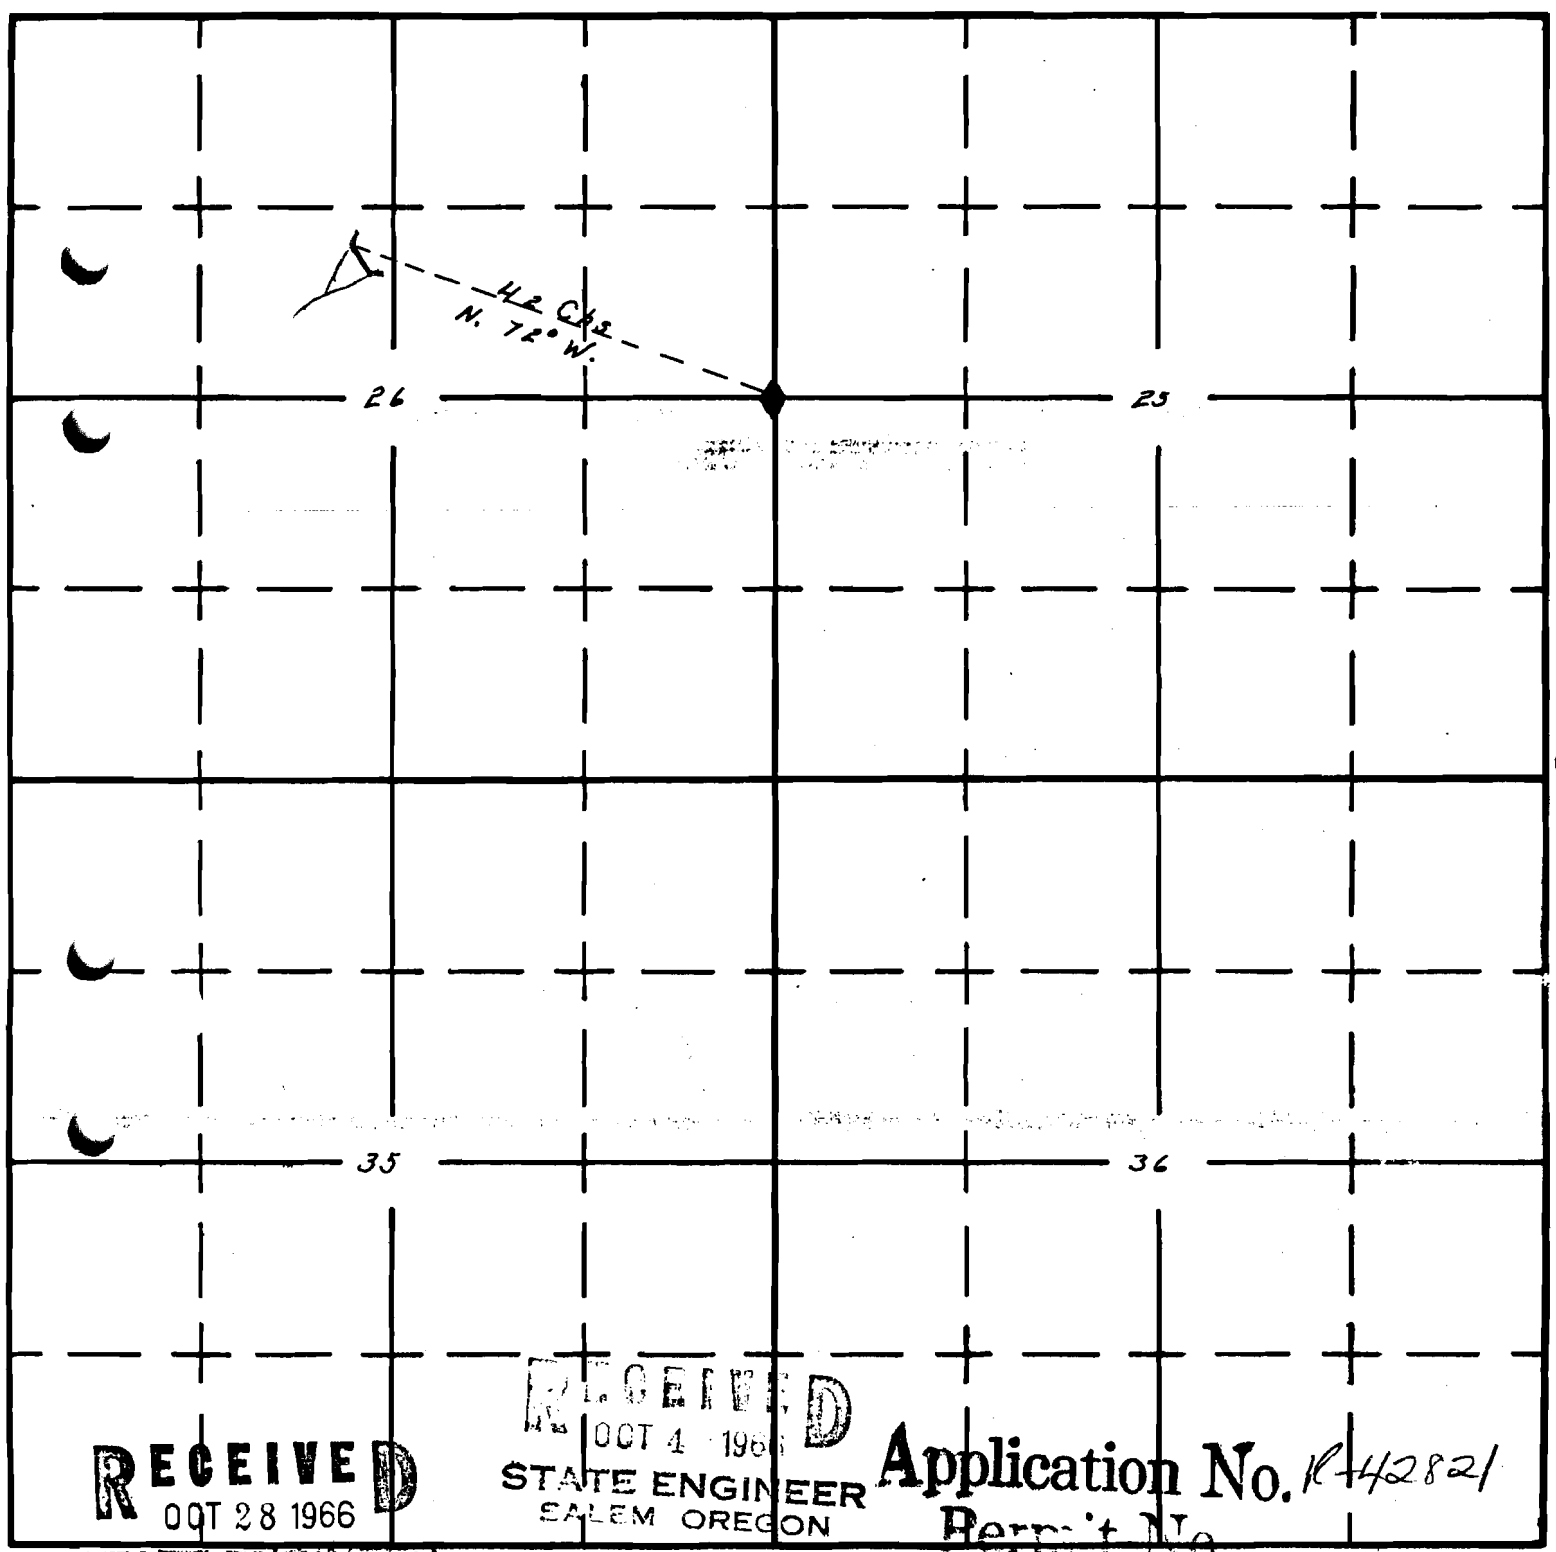

RECEIVED
OCT 28 1966

RECEIVED
OCT 4 1966
STATE ENGINEER
SALEM OREGON

Application No. R 42821
Permit No.

STATE ENGINEER
SALEM OREGON

South

PERMIT No. R 7354