

P-7114-1
Nov. 1965

UNITED STATES
DEPARTMENT OF THE INTERIOR
BUREAU OF LAND MANAGEMENT

E97/

SECTION

22

NE SW

Oregon State Water Filings


TOWNSHIP 39S, RANGE 23E, W. M.

RECEIVED


NOV 30 1968

STATE ENGINEER
SALEM, OREGON

North

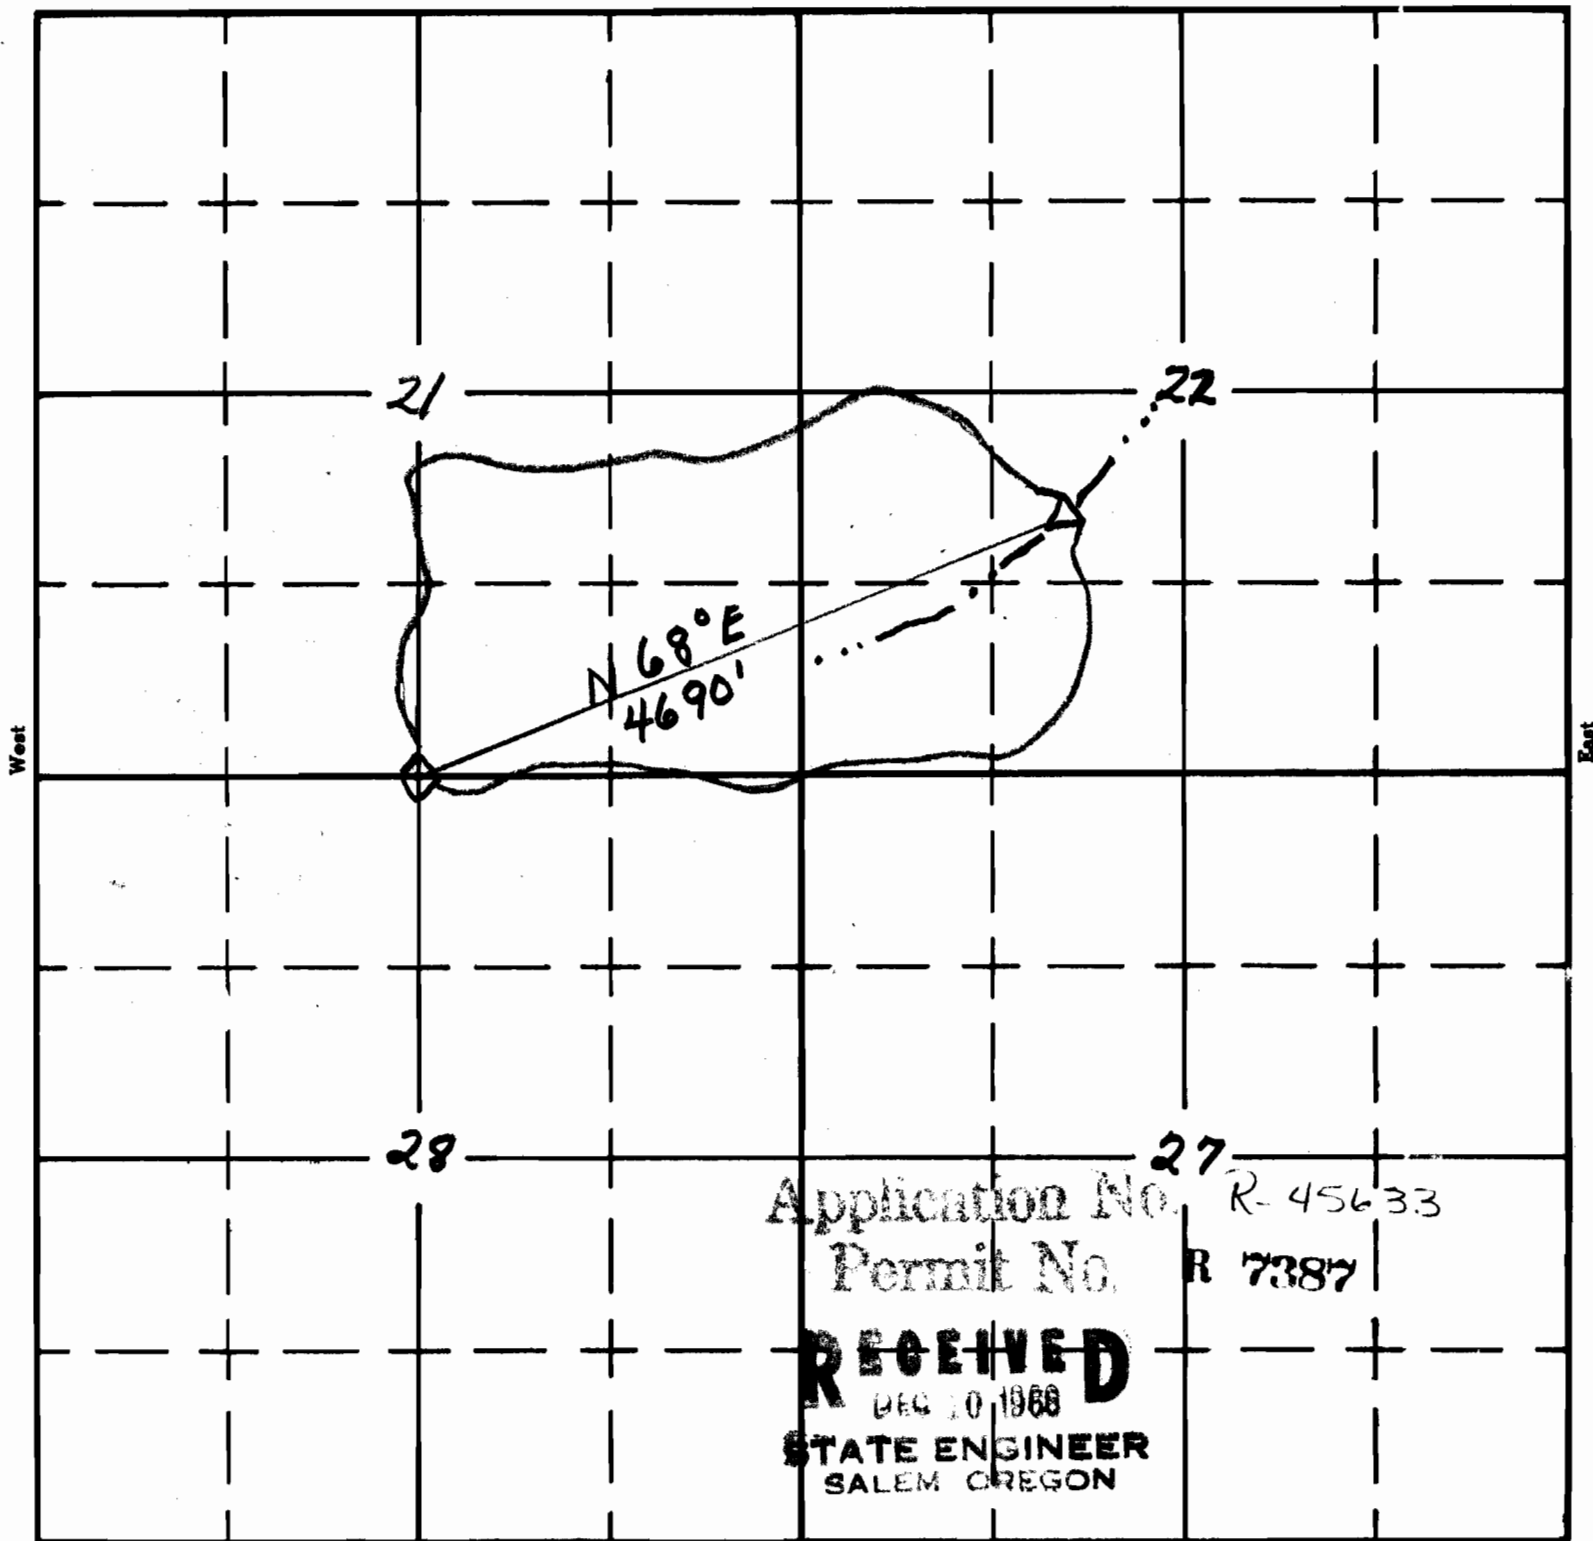

South

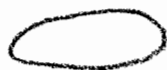

Watershed Area

APPLICATION No.
PERMIT No.