


SECTION

67424

Oregon State Water Filings

TOWNSHIP 34 S., RANGE 23 E., W. M.

North

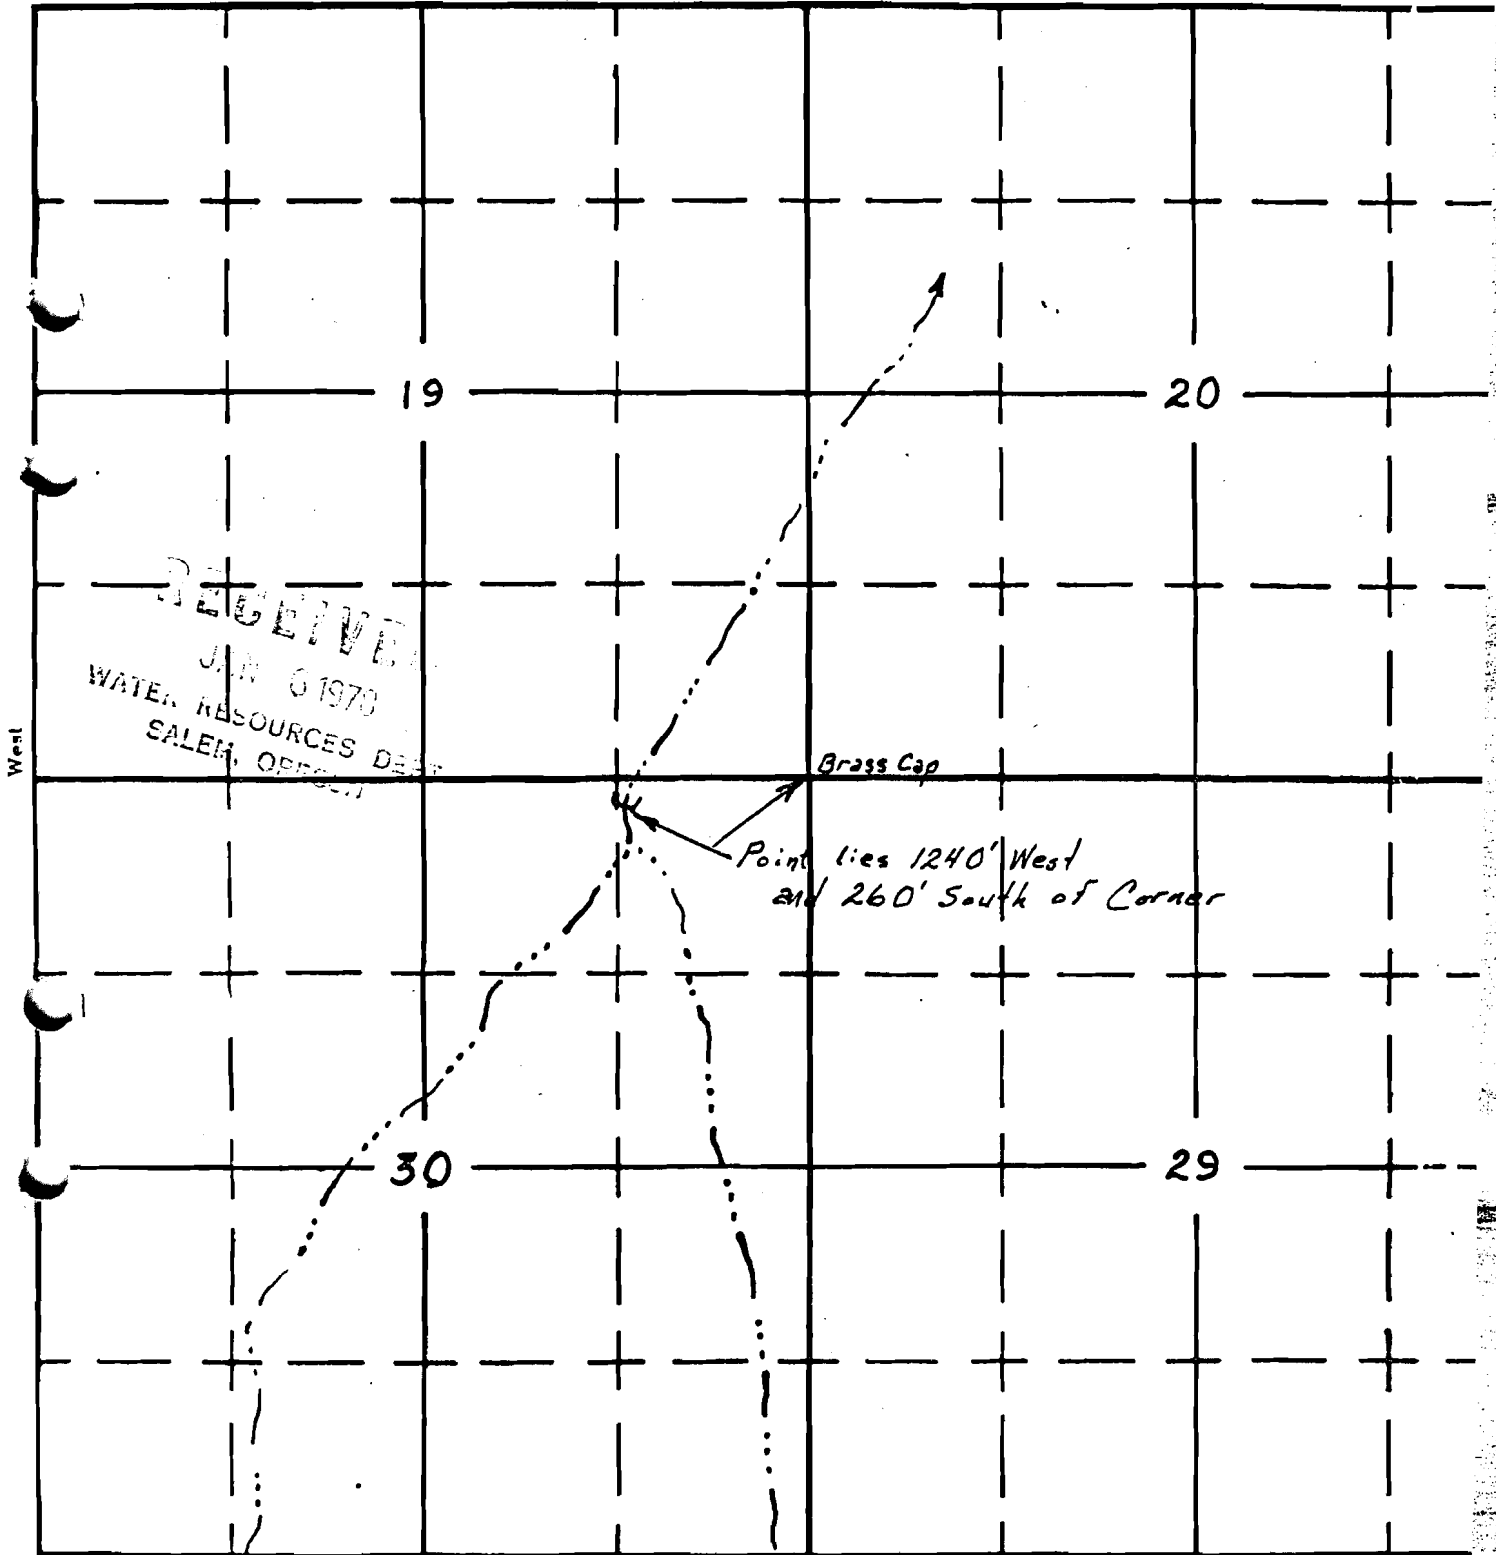

South

APPLICATION No. R-56974

PERMIT No. R-7406