

Permit R7950

67425

Form 9180-31
(June 1967)

UNITED STATES
DEPARTMENT OF THE INTERIOR
BUREAU OF LAND MANAGEMENT

Project

~~Contract~~ Number


4952

~~Map~~ Name

Jim Reservoir

SECTION DIAGRAM

Township 29 S	Range 25 E	Section 20	Meridian W.M.	District Lakeview
Mapper				Date 11-30-78

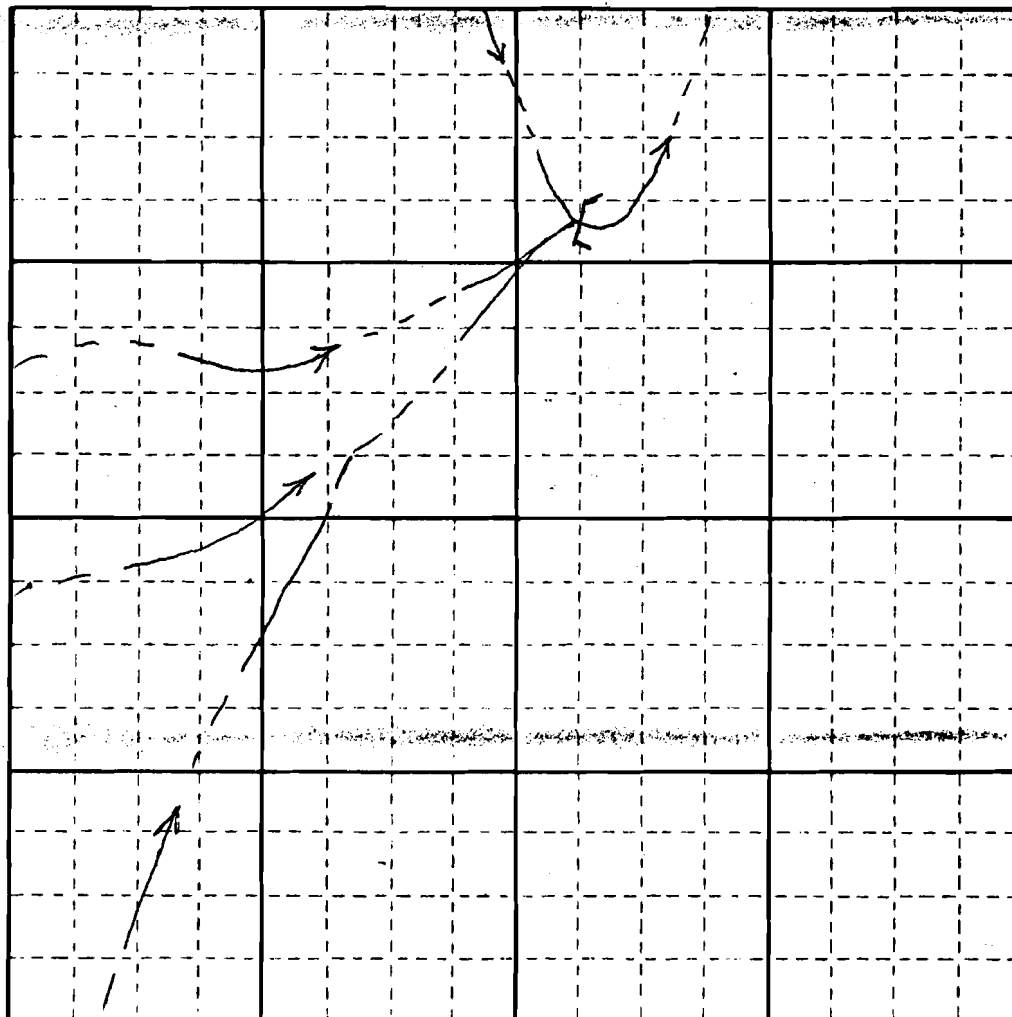

RECEIVED
DEC 4 1978
WATER RESOURCES DEPT.
SALEM, OREGON

SCALE: 1" = 1,000 FT.

LEGEND

Application No. R-58138
Permit No. R 7950

- ☐ THE DAM IS 800' S
- ☐ AND 2100' W OF
- ☐ SEC. COR. 16, 17, 20, 21
- ☐