


67429

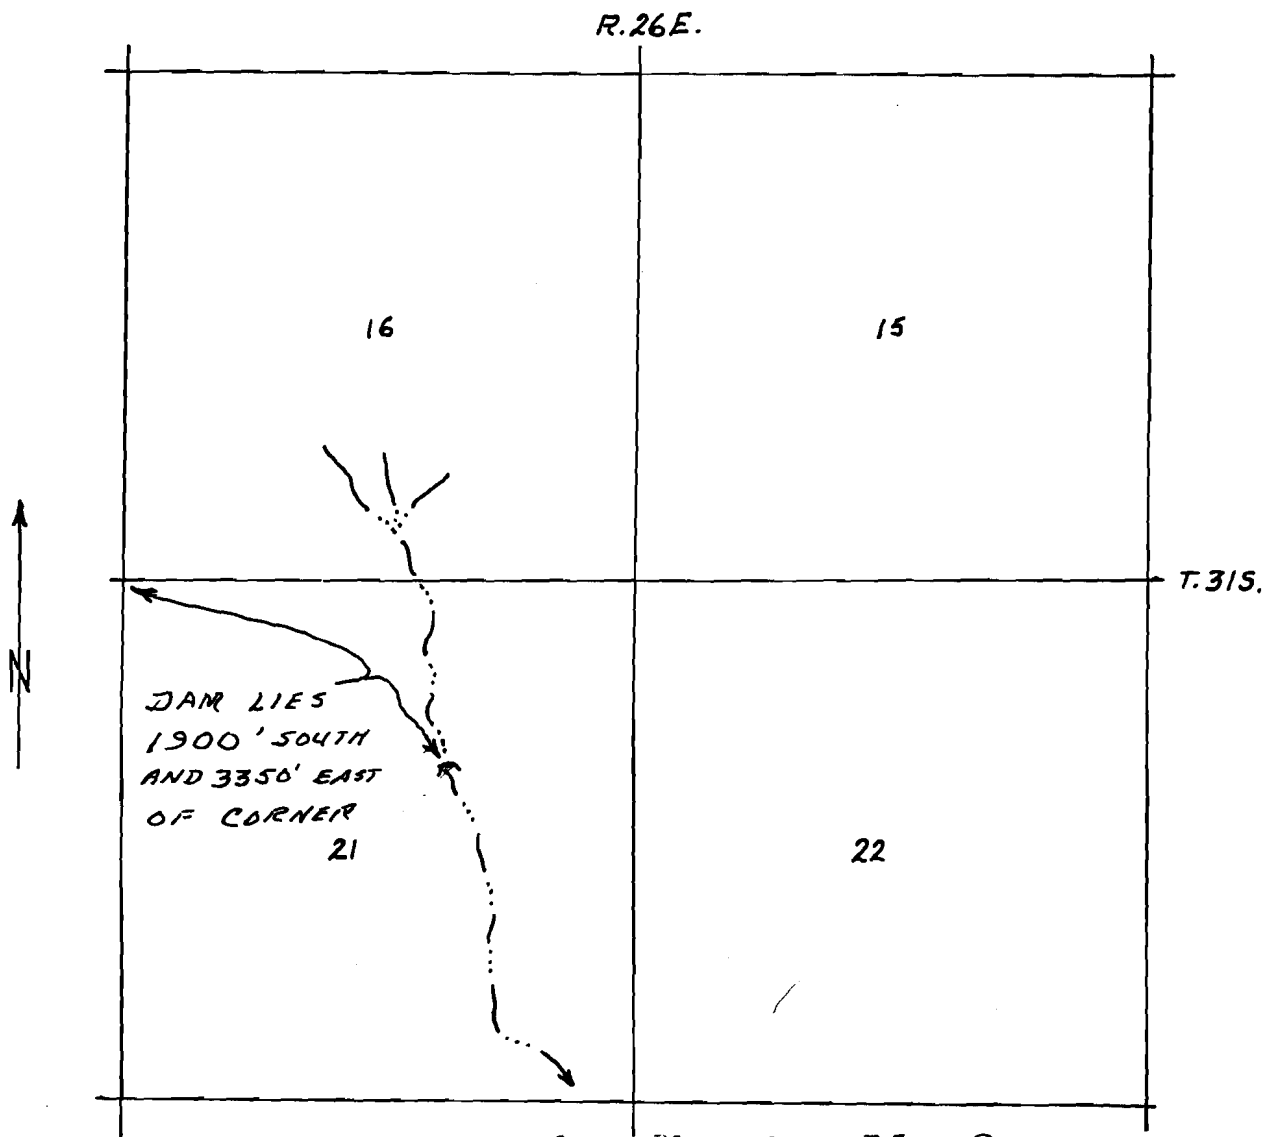

Application No. R-63572
Permit No. R 9305

U. S. DEPARTMENT OF THE INTERIOR
BUREAU OF LAND MANAGEMENT

UPPER LYNCH DRAW RES.

DESIGNED _____
REVIEWED _____
APPROVED _____

DRAWN DAB SCALE 1:24,000

DATE 5-20-82 SHEET 1 OF 1

DRAWING NO. P.N. 5235

RECEIVED

MAY 24 1982

WATER RESOURCES DEPT
BALCH, OREGON