

Bureau of Land Management  
Burns District Office



GROVE CREEK SPRING

\* 5054

T. 32½ S., R. 33 E., SEC. 32, SWSW

Application No. 63172  
Permit No. 48887

Scale: 1 inch = 400 feet

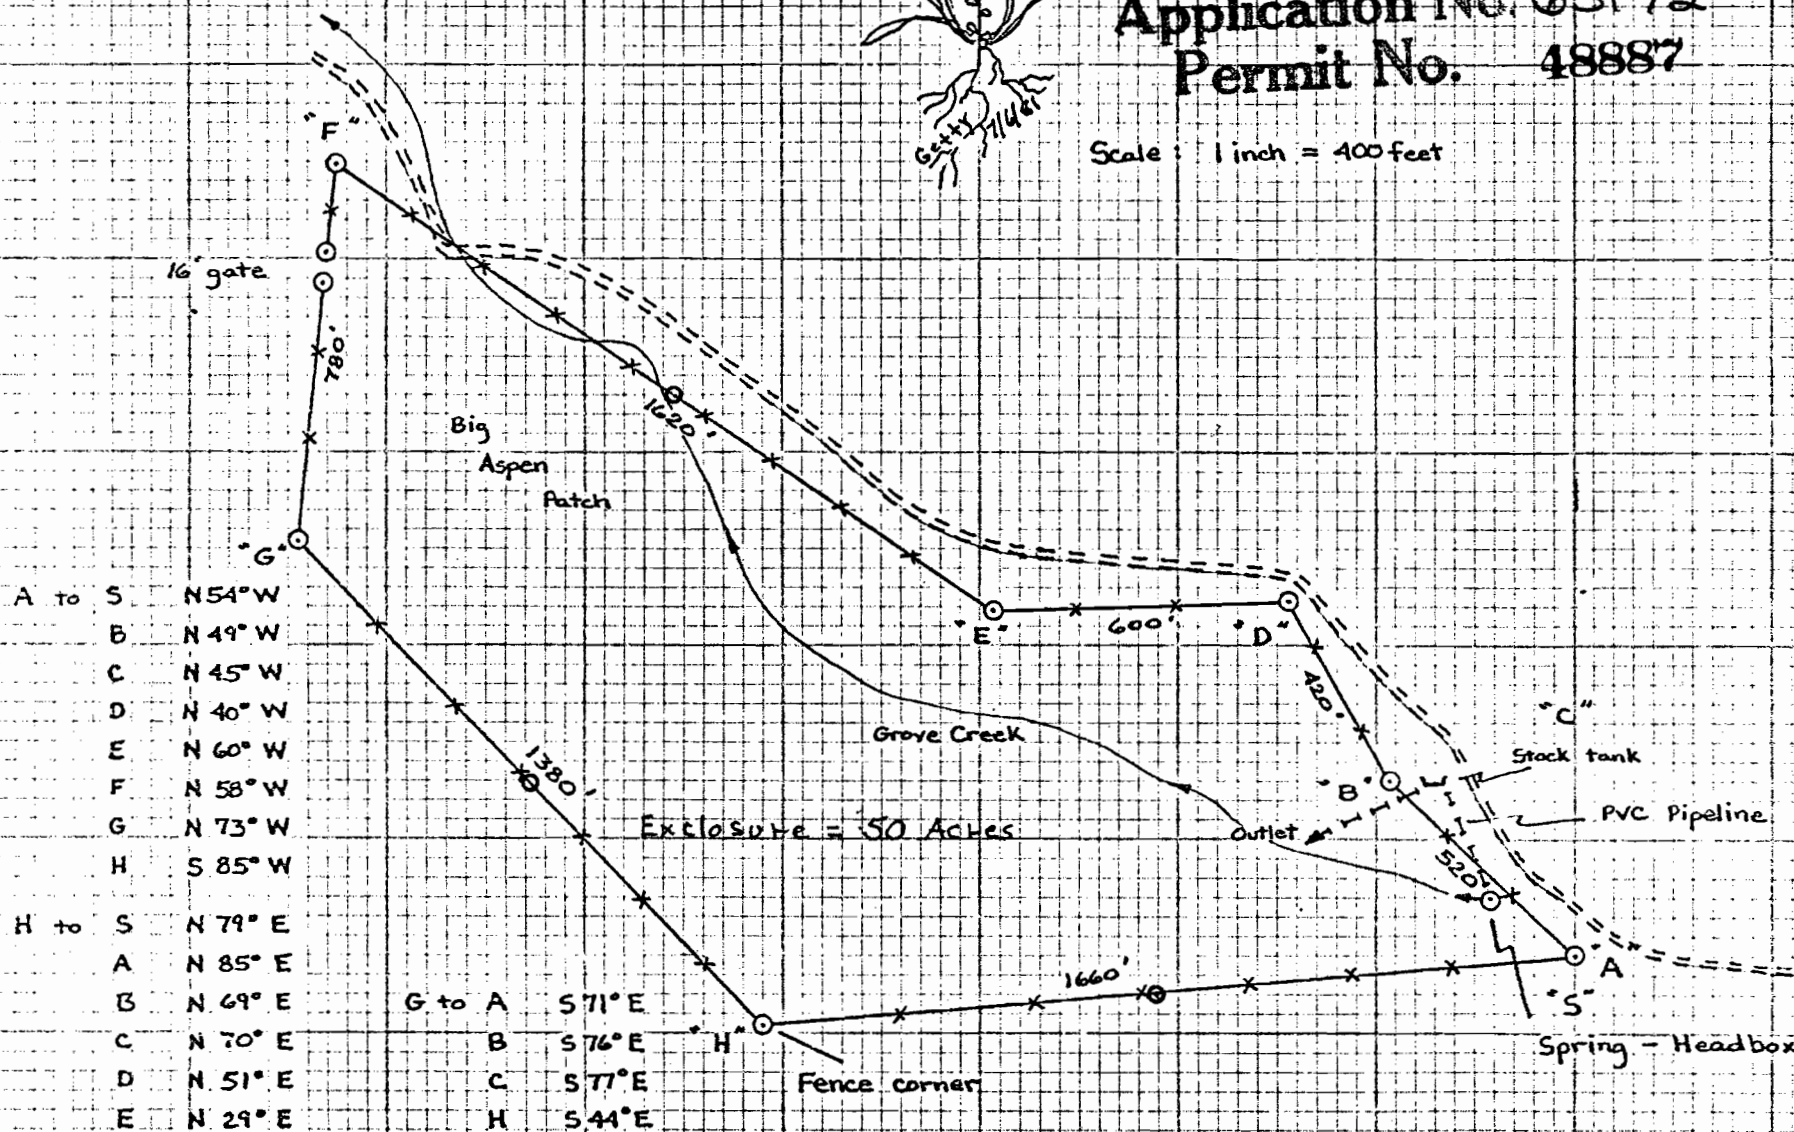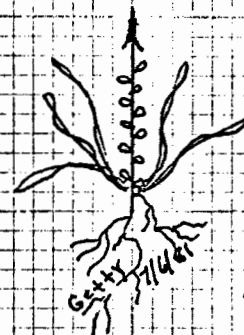

March 1961

DEPARTMENT OF THE INTERIOR  
BUREAU OF LAND MANAGEMENT

Grove Creek Spring  
#5054

SECTION

S. 32

# Oregon State Water Filings

TOWNSHIP 32<sup>1/2</sup> S., RANGE 33 E., W. M.

DEC 14 1981

WATER RESOURCES DEPT.  
SALEM, OREGON

North

Application No. 631724  
Permit No. 48887

Lost Lake

32

33

Grove Creek

4100'

475'

T. 32<sup>1/2</sup> S.  
T. 33 S.

East

5

4

RECEIVED

RECEIVED

APR 11 1983

JAN 12 1983  
WATER RESOURCES DEPT.  
SALEM, OREGON

WATER RESOURCES DEPT.  
SALEM, OREGON

South

APPLICATION No.

PERMIT No.