


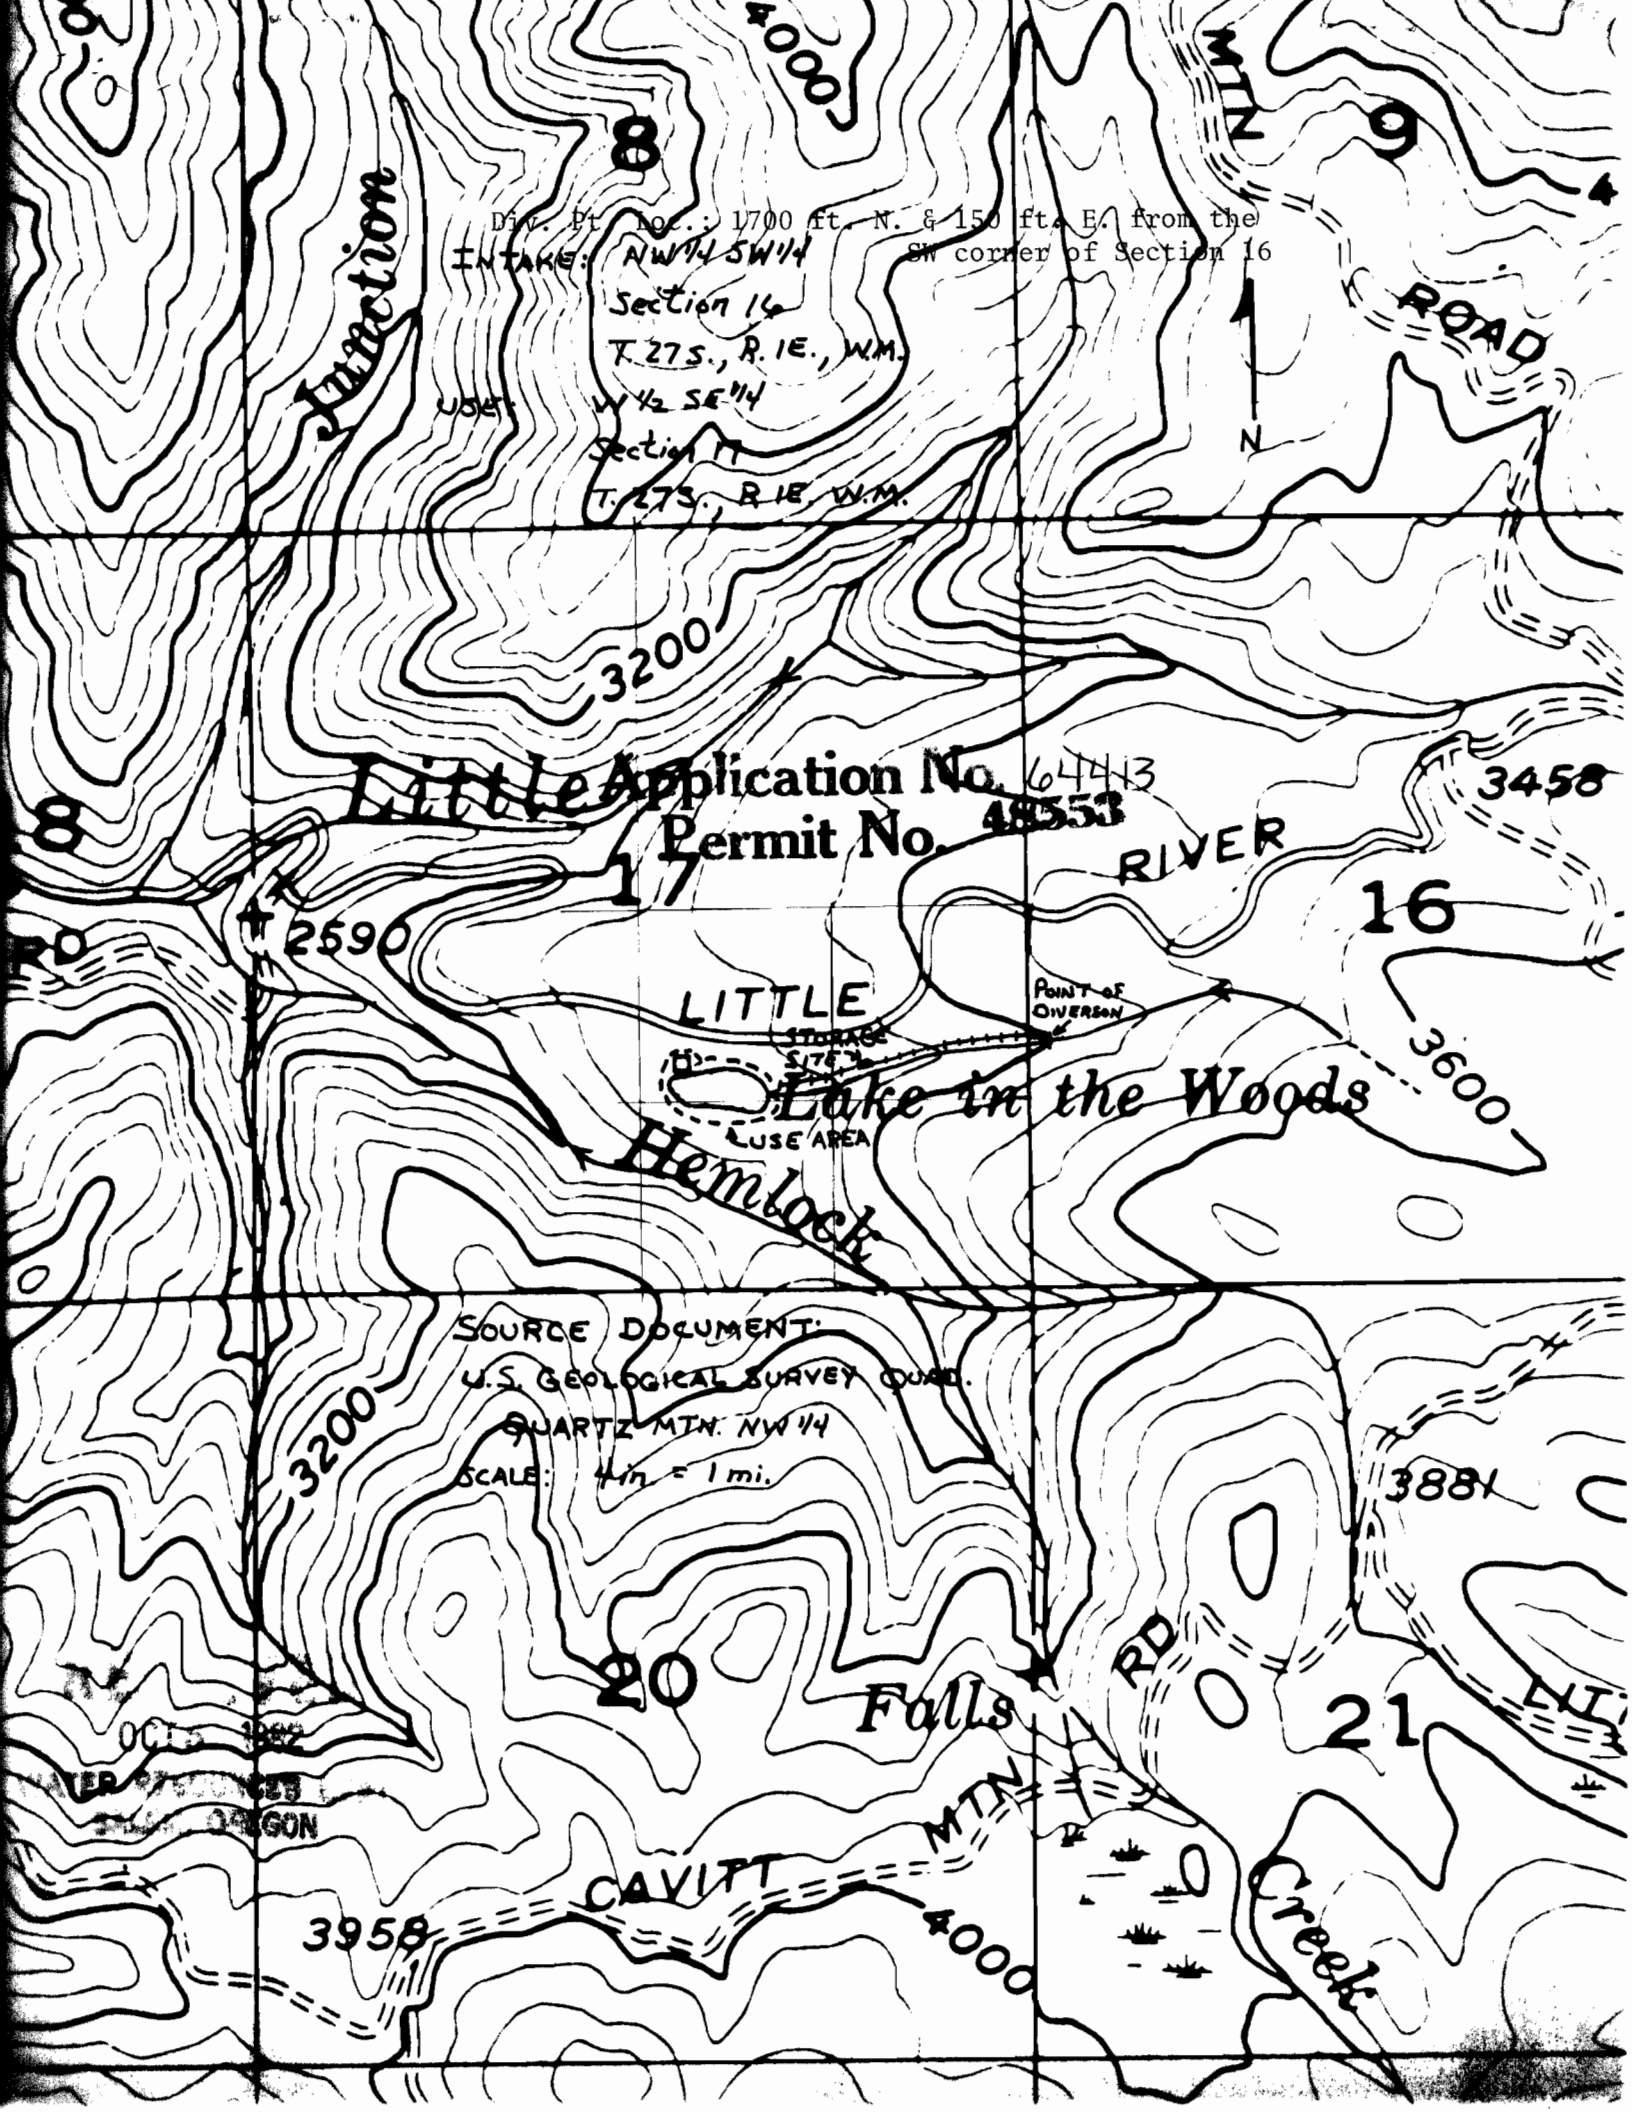

Dist. Pt. Loc.: 1700 ft. N. & 150 ft. E. from the
INTAKE: NW 1/4 SW 1/4 SW corner of Section 16

Section 16
T. 27 S., R. 1 E., W.M.

USE: W 1/2 SE 1/4
Section 17
T. 27 S., R. 1 E., W.M.

Little Application No. 64413
Permit No. 48553

LITTLE

STORAGE
SITE

Lake in the Woods

USE AREA

Hemlock

SOURCE DOCUMENT:
U.S. GEOLOGICAL SURVEY QUAD.

QUARTZ MTN. NW 1/4

SCALE: 1 in = 1 mi.

20

Falls

21

CAVITT

MTN

Creek

3958

4000

3881

16

3200

2590

3458

3600

3200

MTN

9

8

4000

JUNCTION

ROAD

N

8

RD

20

OCT 1982
WATER OF THE STATE OF OREGON