

SECTION


16

Oregon State Water Filings

TOWNSHIP 36S, RANGE 29E, W. M.

SWSE

North

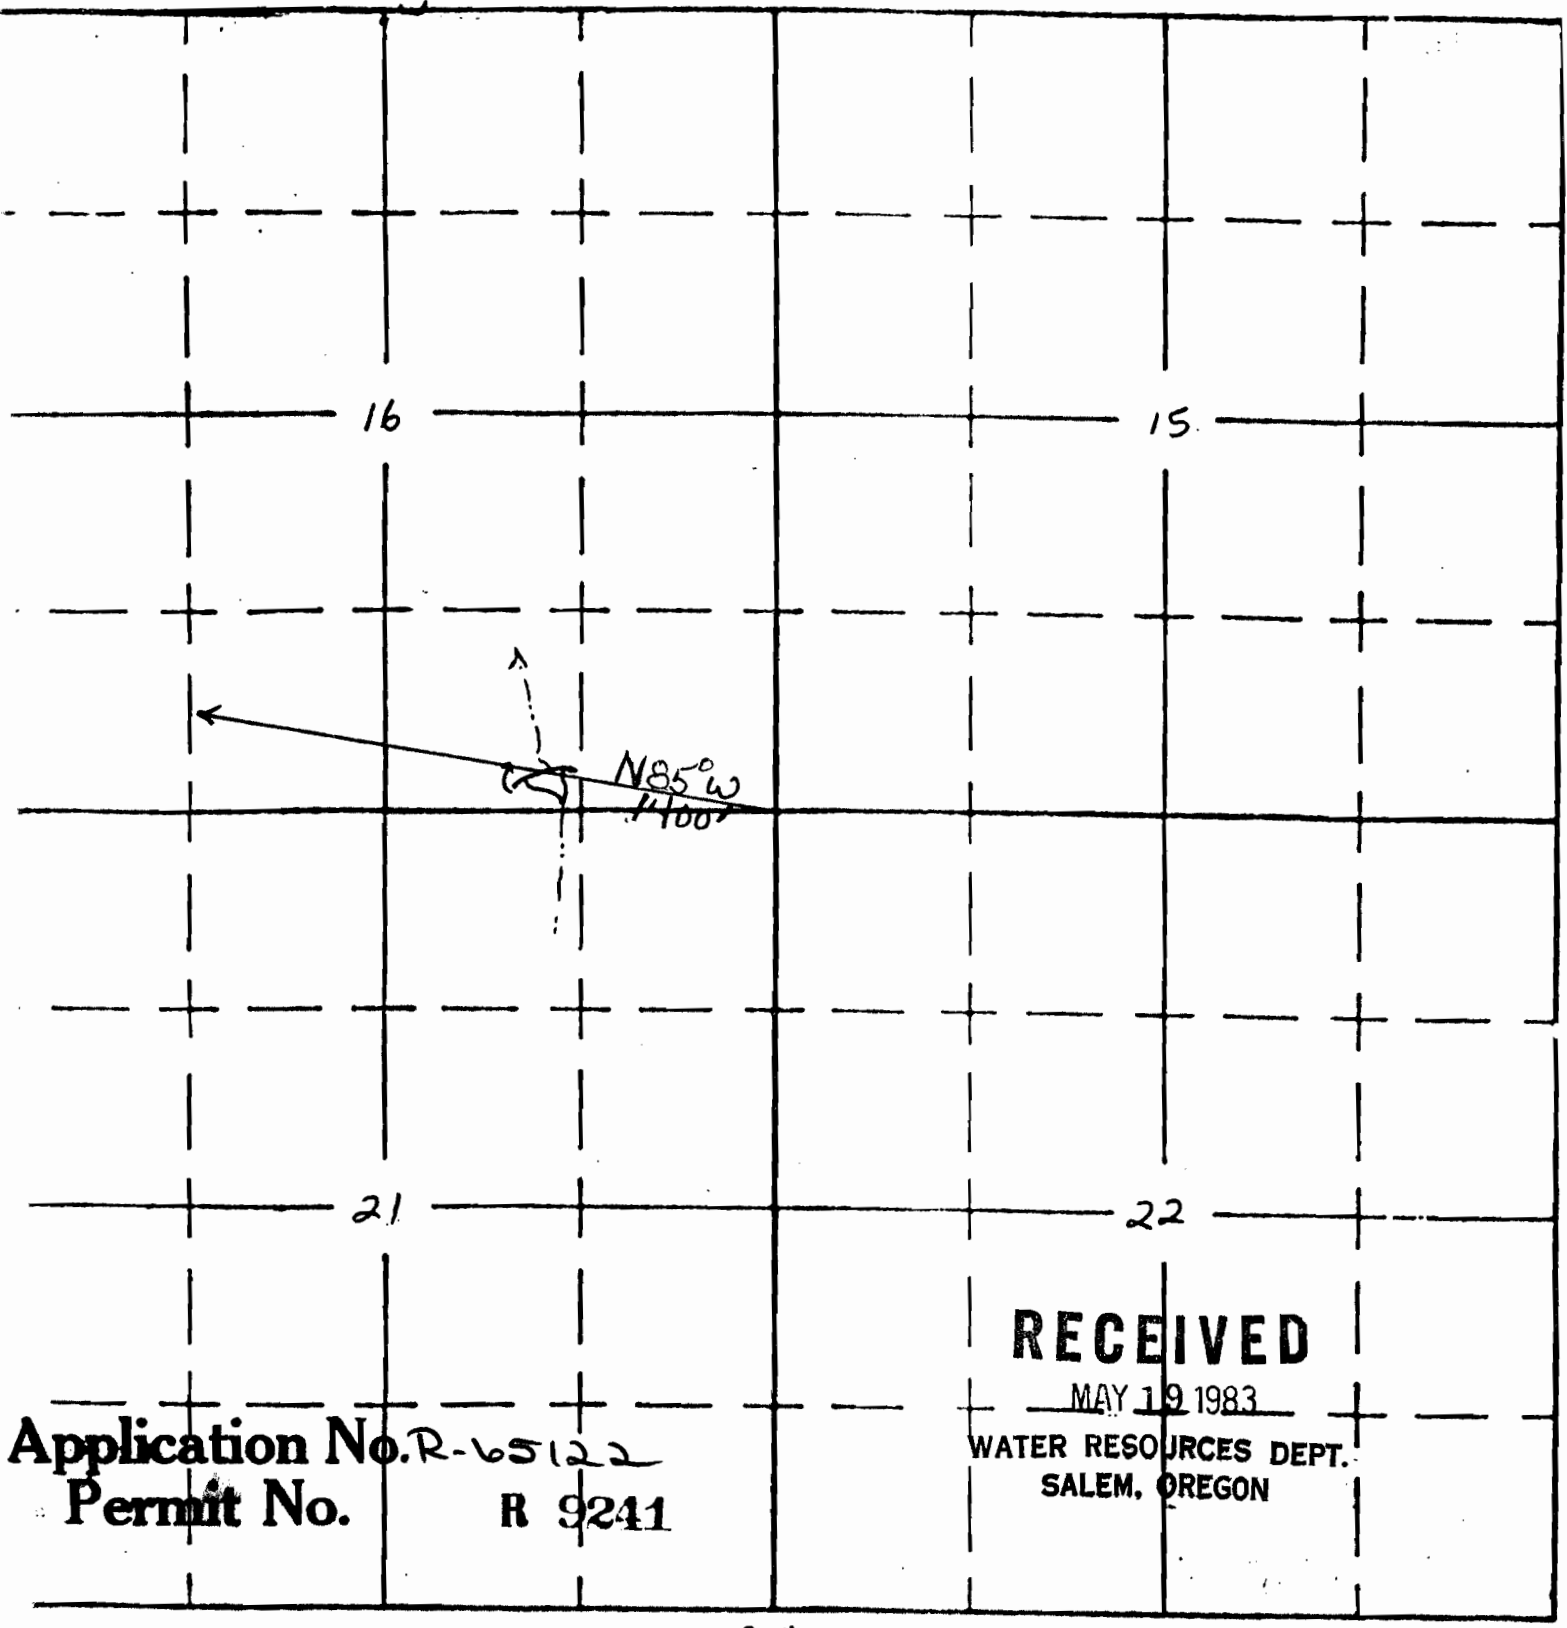

Application No. R-65122
Permit No. R 9241

RECEIVED

MAY 19 1983

WATER RESOURCES DEPT.
SALEM, OREGON

South

APPLICATION No.
PERMIT No.