

R9827
67444

Form OR-010-7300-2
4/83

UNITED STATES
DEPARTMENT OF THE INTERIOR
BUREAU OF LAND MANAGEMENT

Section

2

Township 39 S.


Appl. No. R-66090

Range 23 E.

Permit No. R 9827

Will. Mer.

WEST CORRAL RES. (5404)

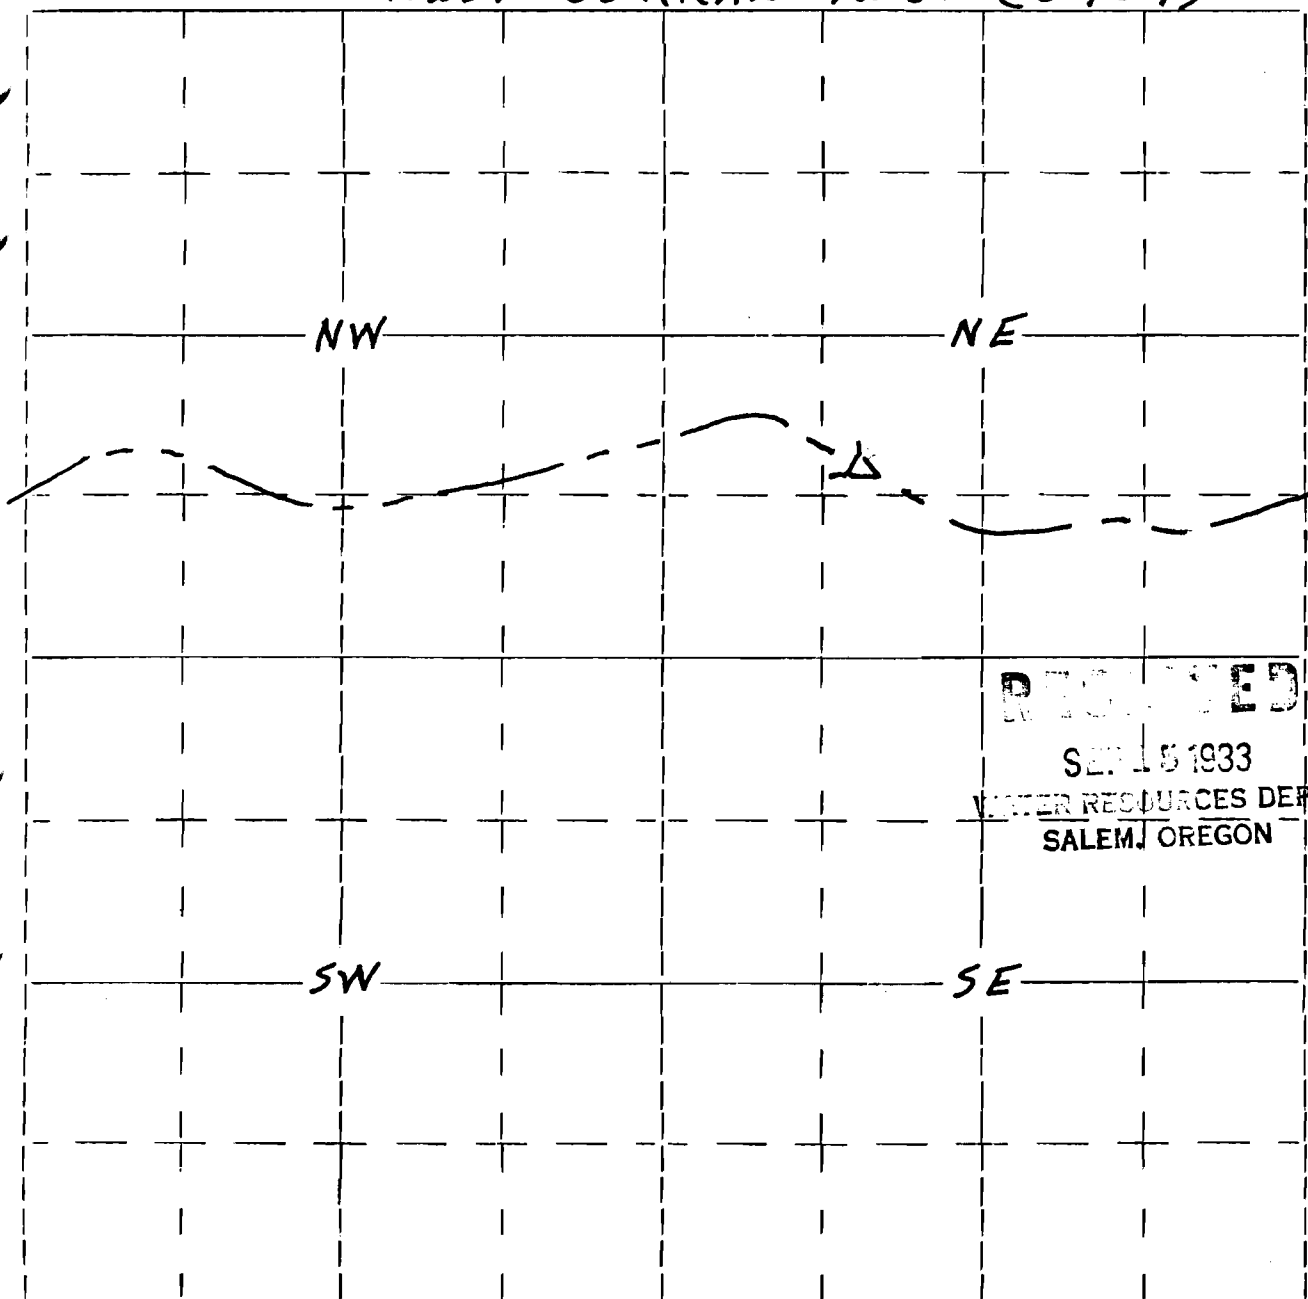

THE DAM IS 1700 FT. WEST AND 1350 FT.
SOUTH OF THE NE CORNER OF SEC. 2