

29829
67445

Form OR-010-7300-2
4/83

UNITED STATES
DEPARTMENT OF THE INTERIOR
BUREAU OF LAND MANAGEMENT

Section 26

Township 38 S.


Appl. No. R-66092

Range 12 E.

Permit No. R 9829

Will. Mer.

PEDDLERS RES. (5405)

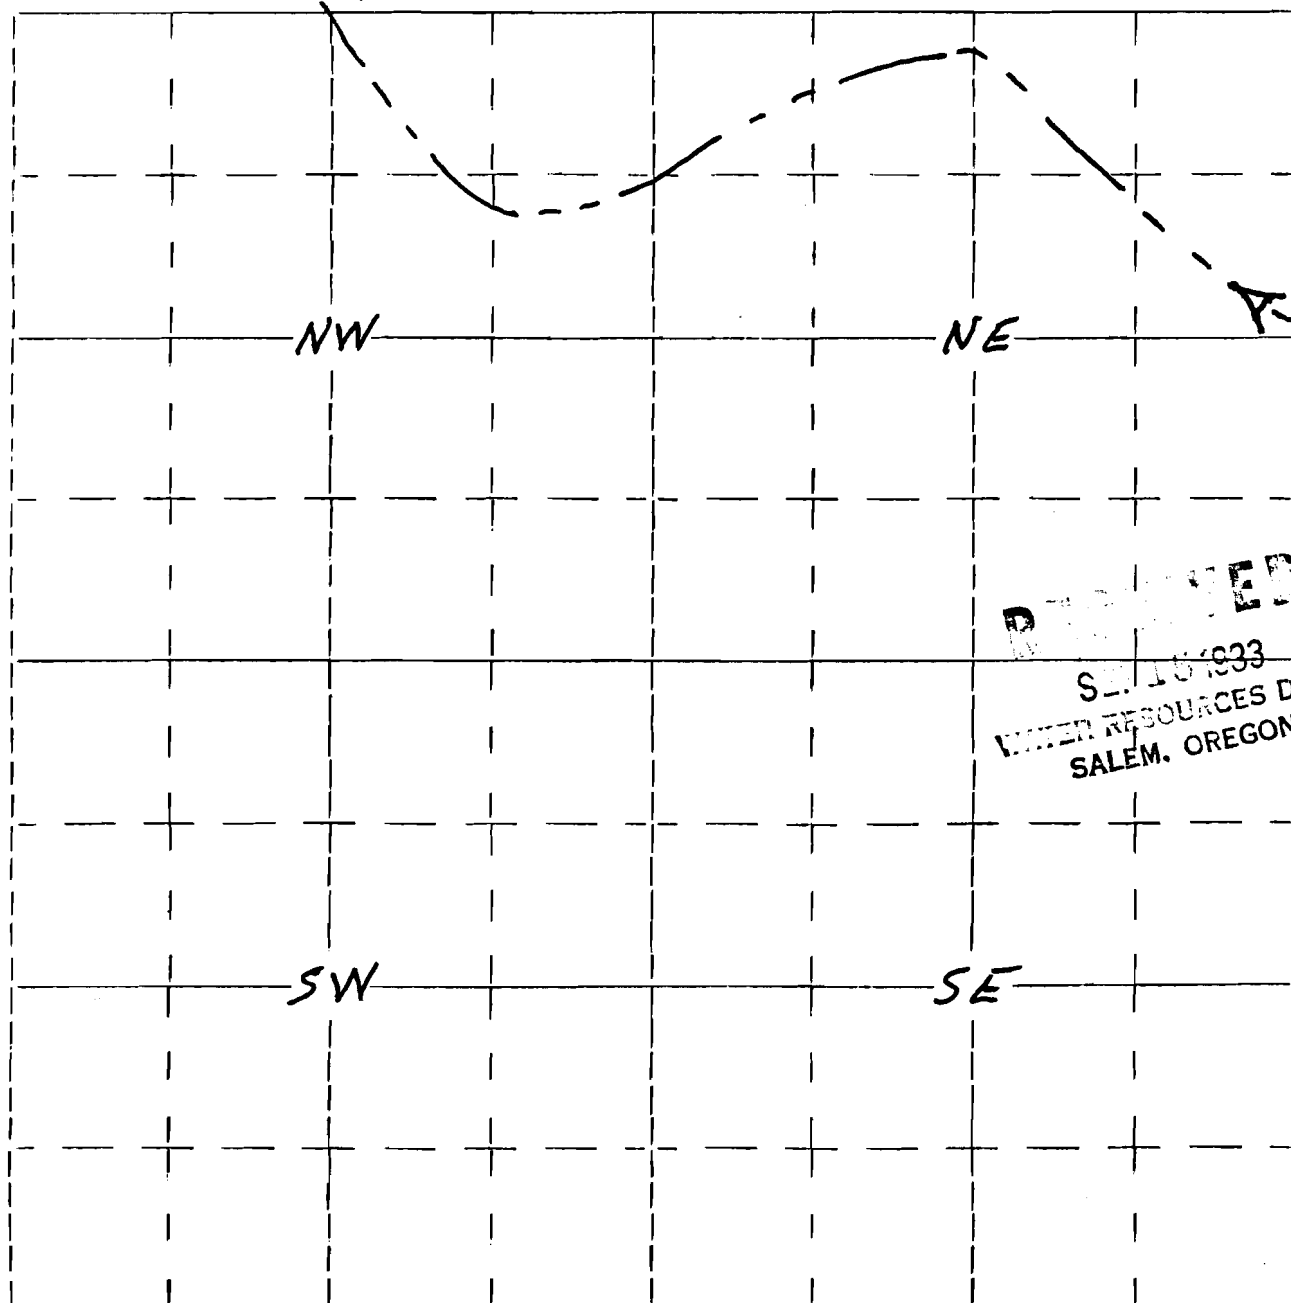

THE DAM IS 900 FT. SOUTH AND 150 FT. WEST OF THE N.E. COR. SEC. 26.