


SECTION

TOWNSHIP _____, RANGE _____, W. M.

North

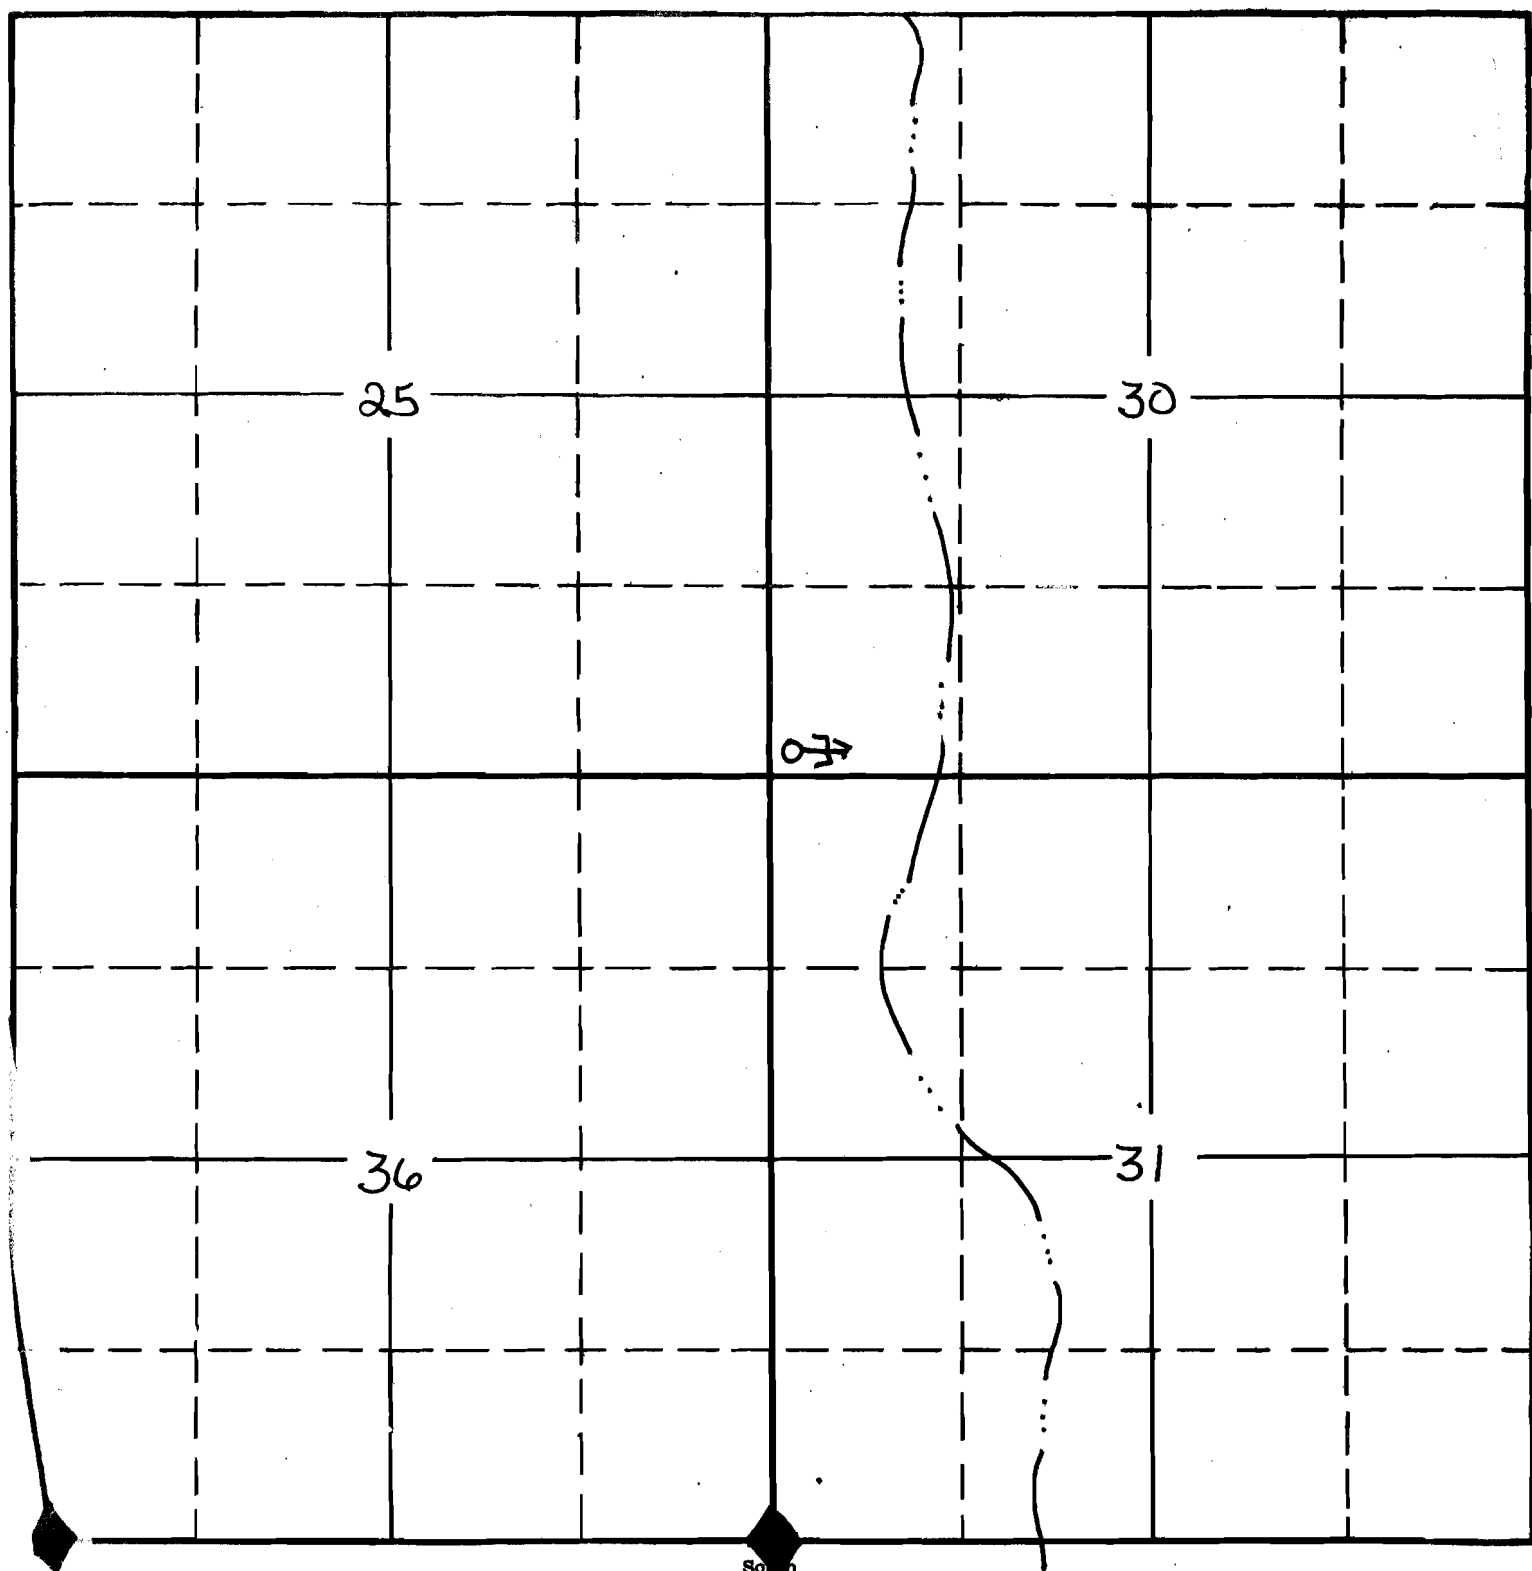

RECEIVED

SEP 19 1983
TER RESOURCES DEPT.
SALEM, OREGON

APPLICATION No. 66146
PERMIT No.
48380