


SECTION 33
NESE

5308 - West Ridge Res.

TOWNSHIP 21 S, RANGE 31 E, W. M.

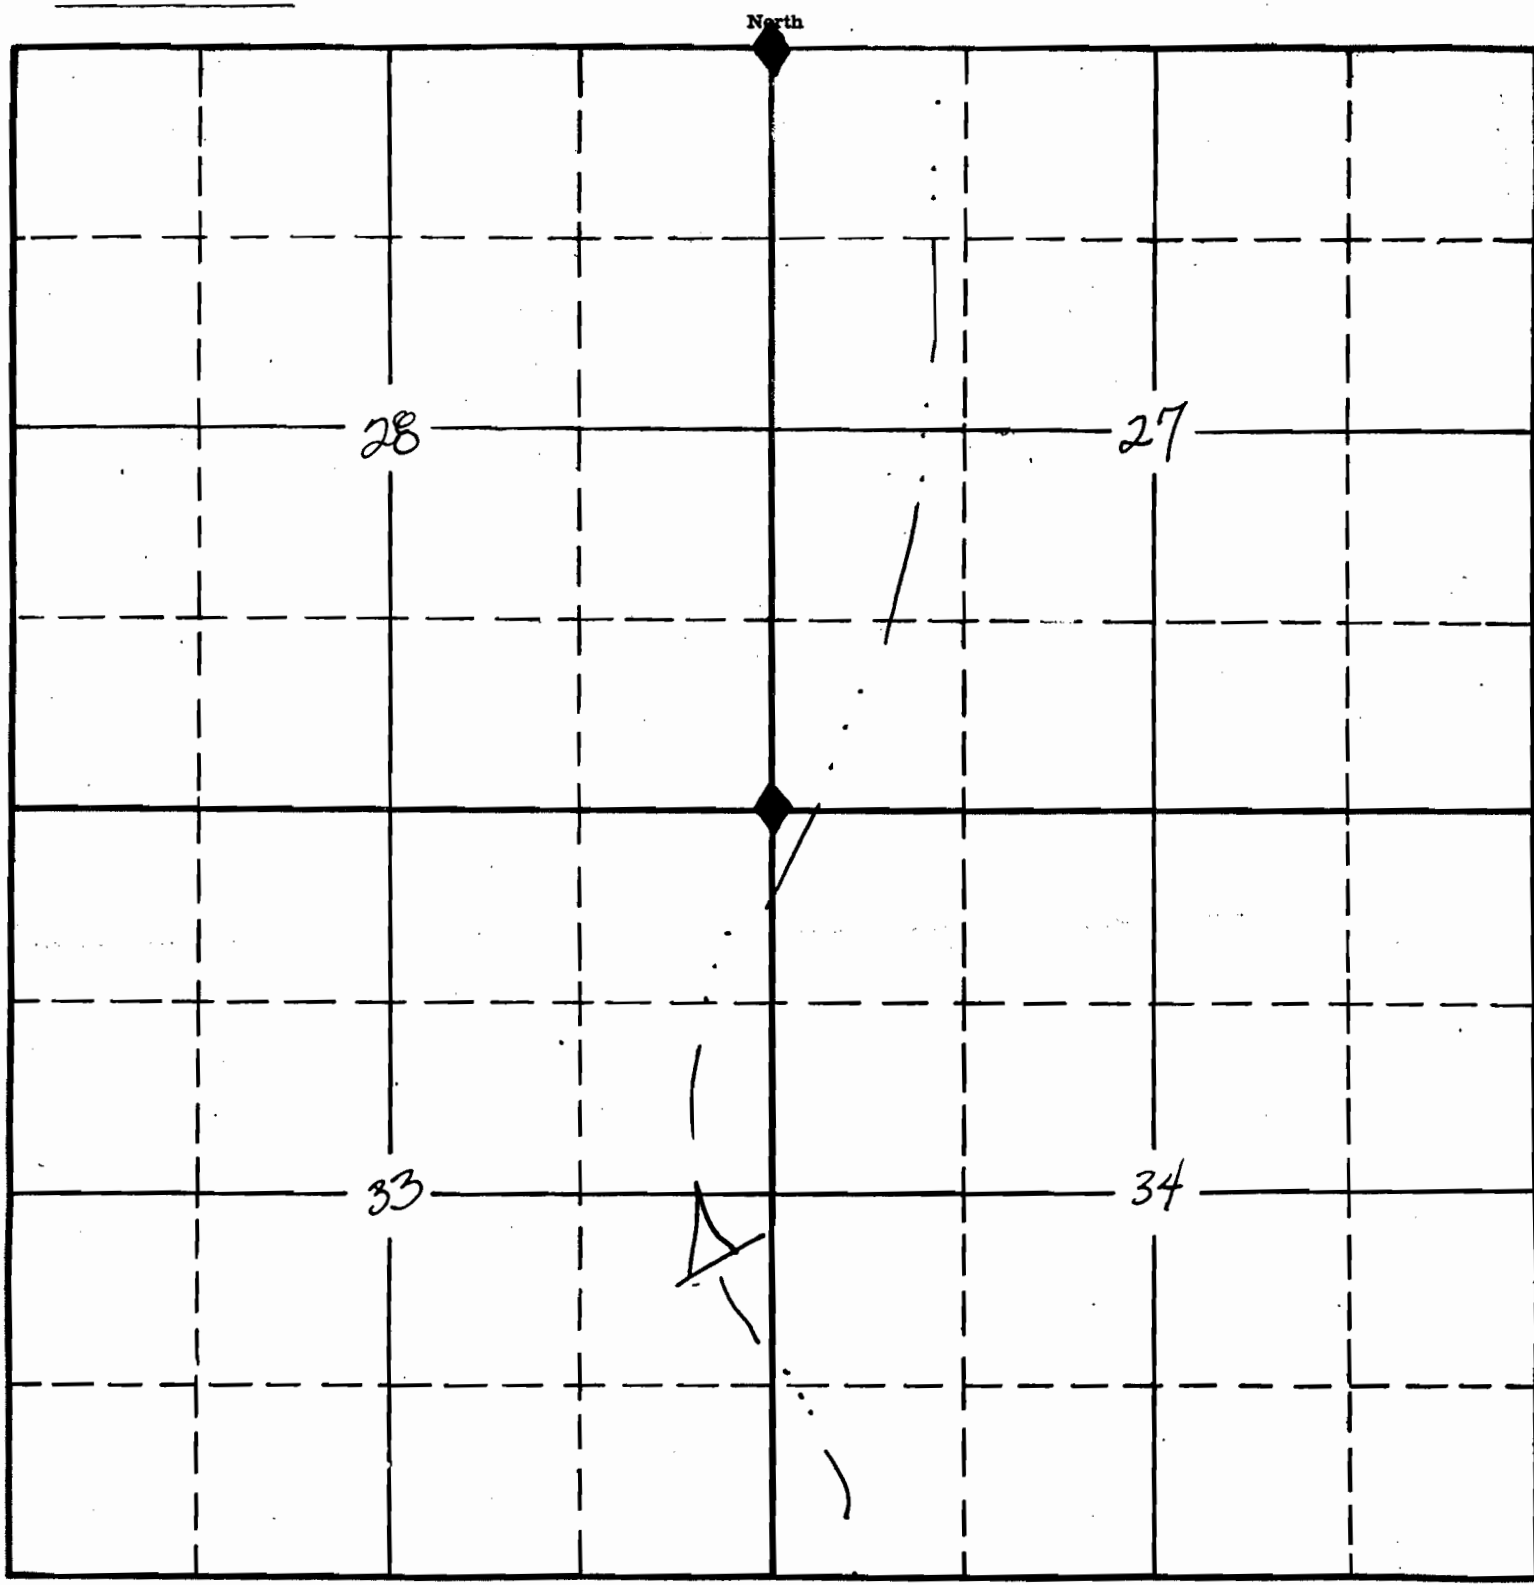

RECEIVED

SEP 19 1983
WATER RESOURCES DEPT.
REGON

APPLICATION No. R-66171
PERMIT No.
R11168