

Form OR-010-7300-2
4/83

UNITED STATES
DEPARTMENT OF THE INTERIOR
BUREAU OF LAND MANAGEMENT

Section

24

Township 28 south

Appl. No. R-66279


NWNE

Range 24 east

Permit No. **R10564**

Will. Mer.

Jerry's Reservoir # 1557

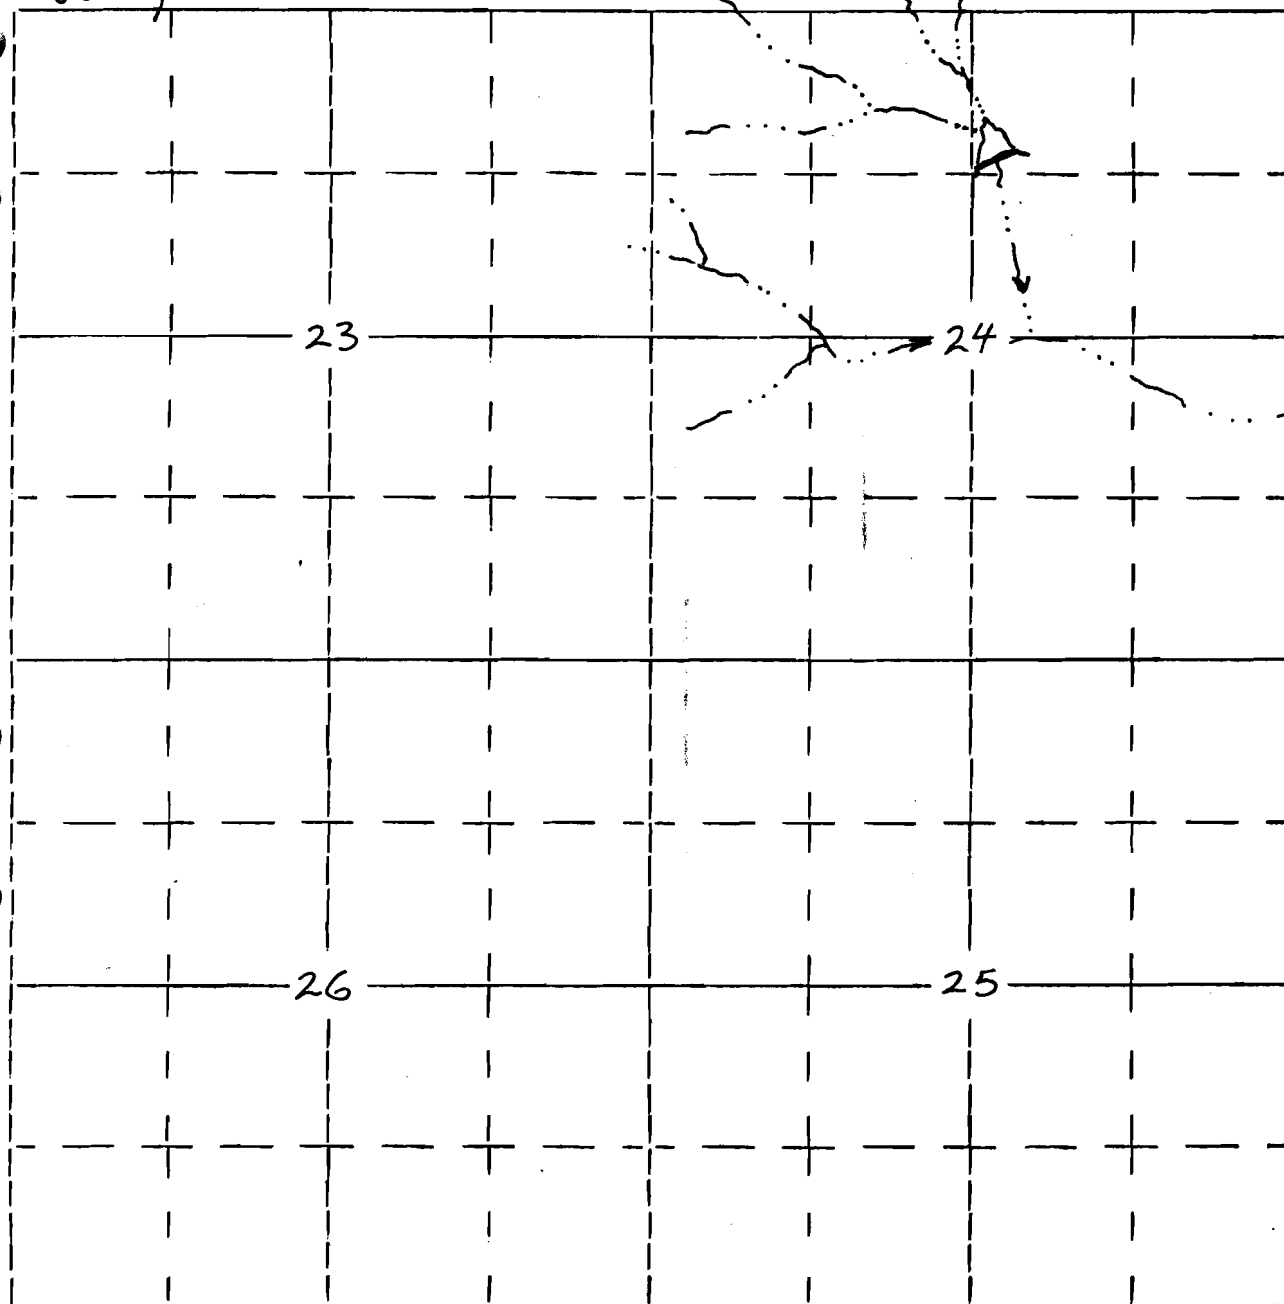

1560' S., 2520' W. of NE Corner of section 24