

Form OR-010-7300-2
4/83

UNITED STATES
DEPARTMENT OF THE INTERIOR
BUREAU OF LAND MANAGEMENT

Section

1

SWNW

Township 40 south


Range 23 east

Appl. No. R-66280

Permit No. R10565

Will. Mer.

Lake Reservoir # 1143

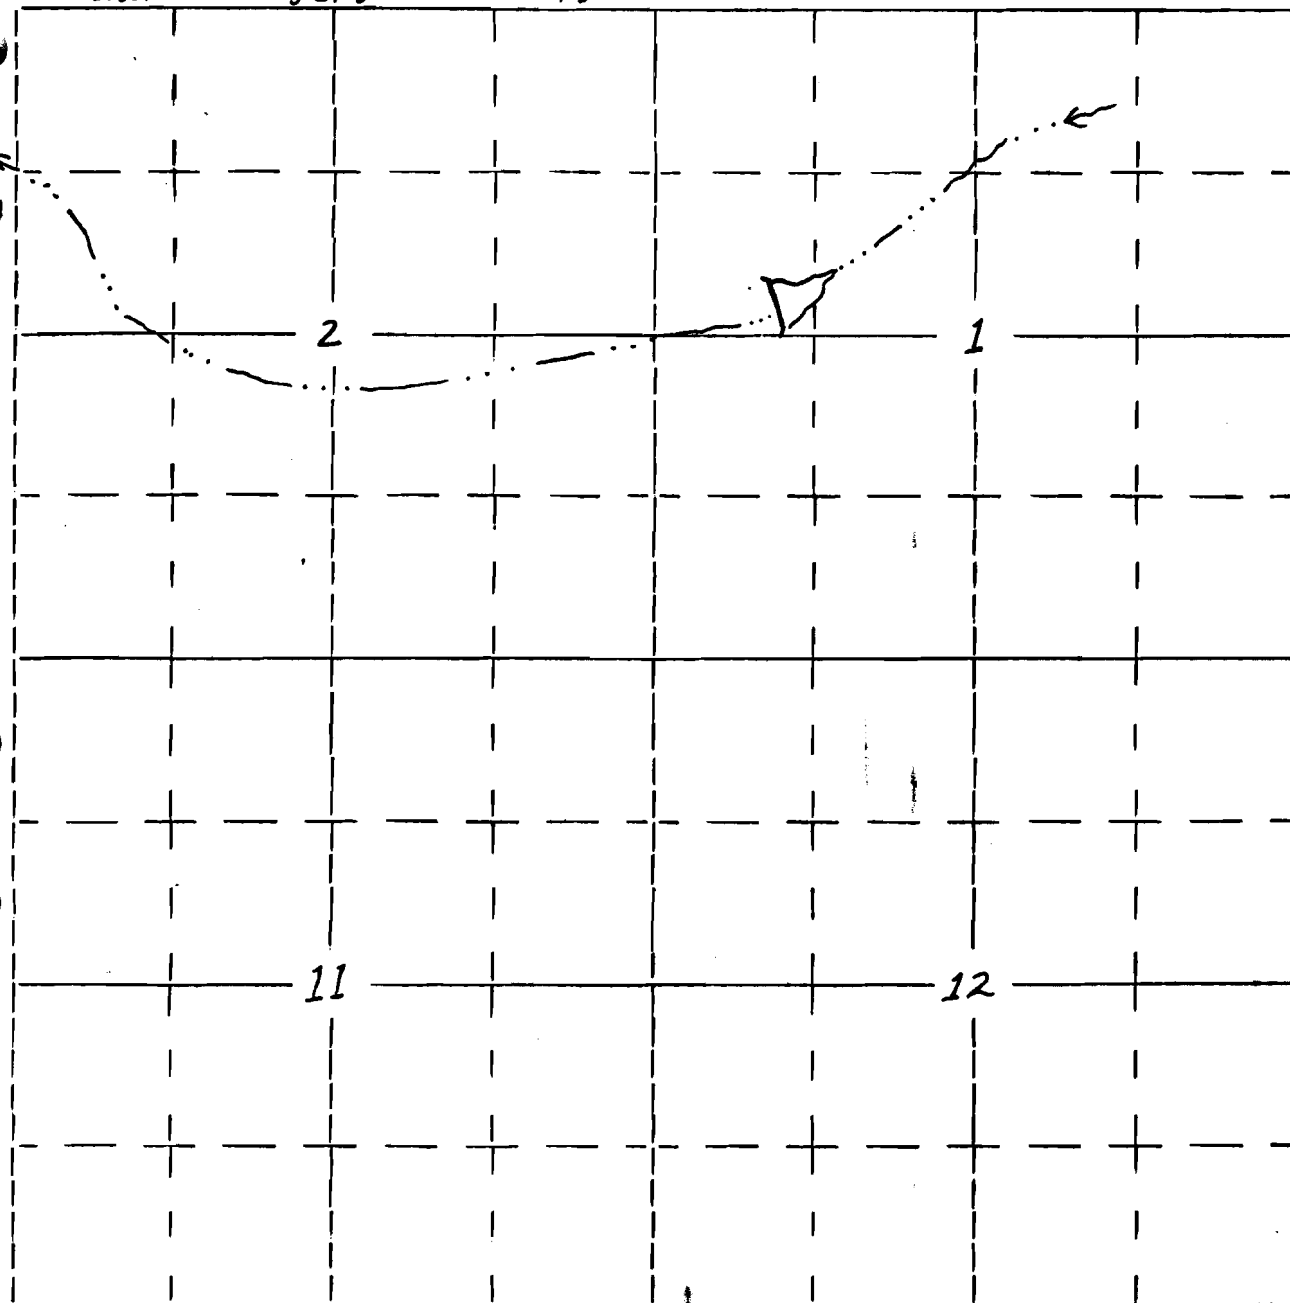

2380' S., 1190' E. of NW corner of section 1