

Form OR-010-7300-2  
4/83

UNITED STATES  
DEPARTMENT OF THE INTERIOR  
BUREAU OF LAND MANAGEMENT

Section  
27

SENE

Township 39 south


Range 23 east

Appl. No. R-66281

Permit No. R10566

Will. Mer.

Deano Reservoir #1195

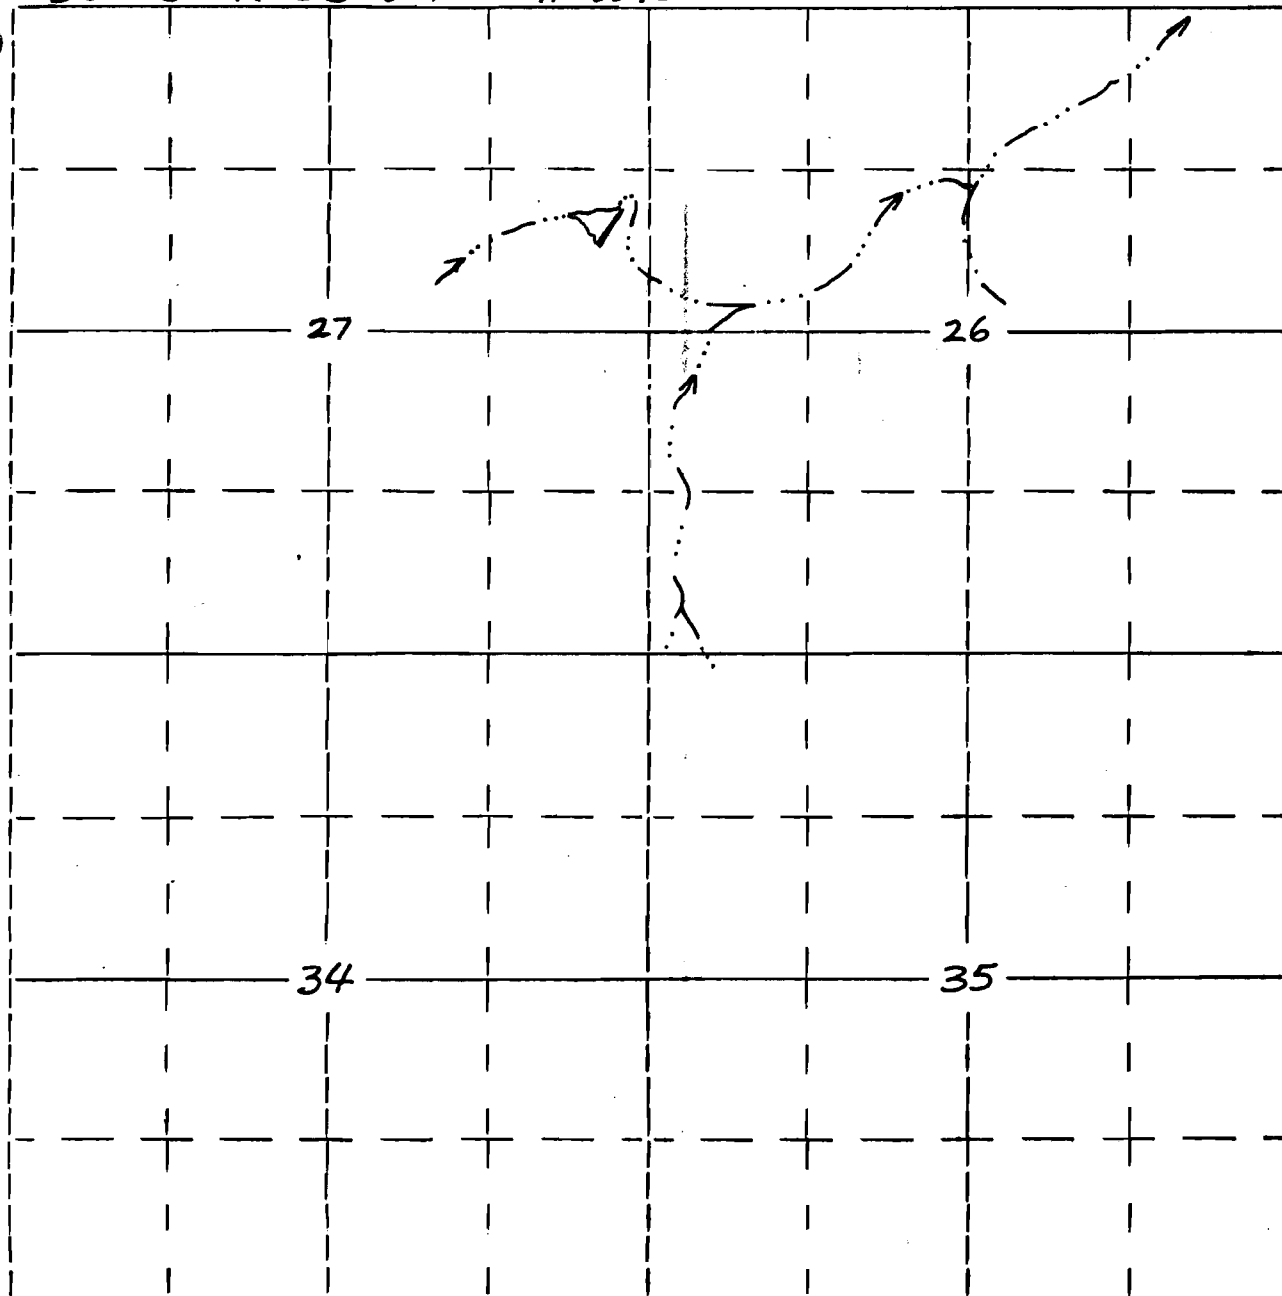

1800' S., 250' W. of NE Corner of section 27