

67453

Form OR-010-7300-2
4/83

UNITED STATES
DEPARTMENT OF THE INTERIOR
BUREAU OF LAND MANAGEMENT


Section 34
NE NE

Township 39S
Range 23E

Appl. No. R-66284
Permit No. R10569

Will. Mer.

Canyon Res. #1141

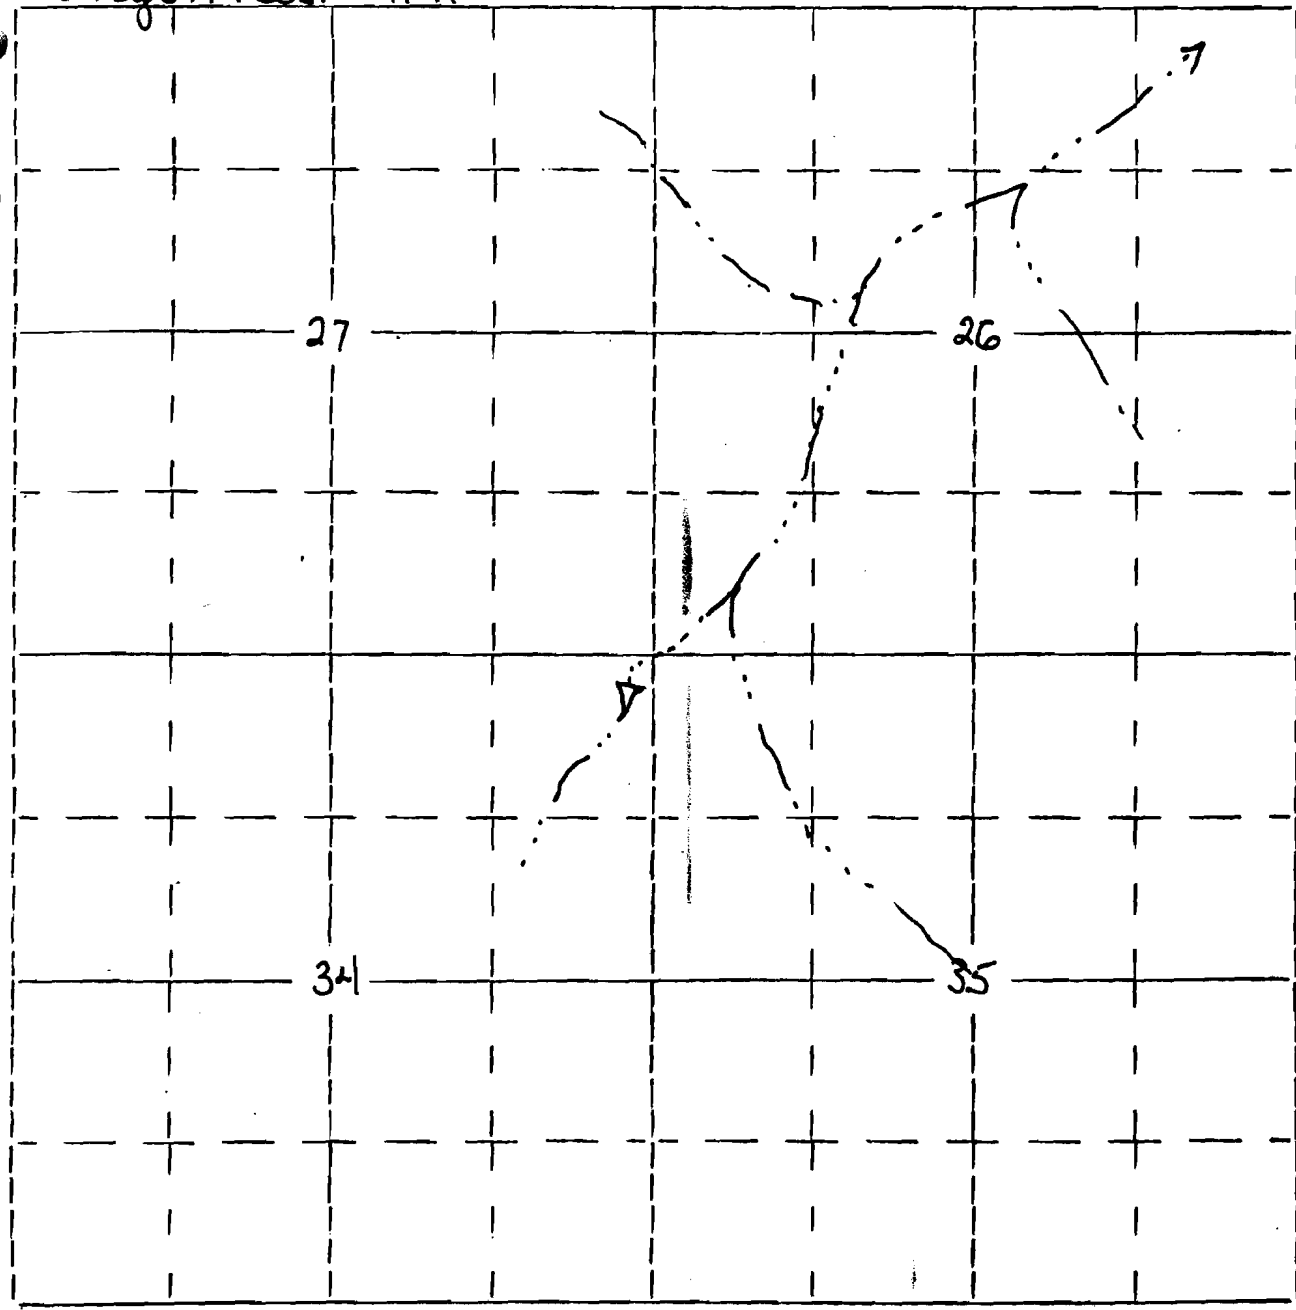

350' S., 200' W., of NE corner of section 34