

Form OR-010-7300-2
4/83


UNITED STATES
DEPARTMENT OF THE INTERIOR
BUREAU OF LAND MANAGEMENT

Section

3 NESE
T37S
R28E

Lower West Gulch
(5514)

Appl. No. R-66285
Permit No. **R10570**

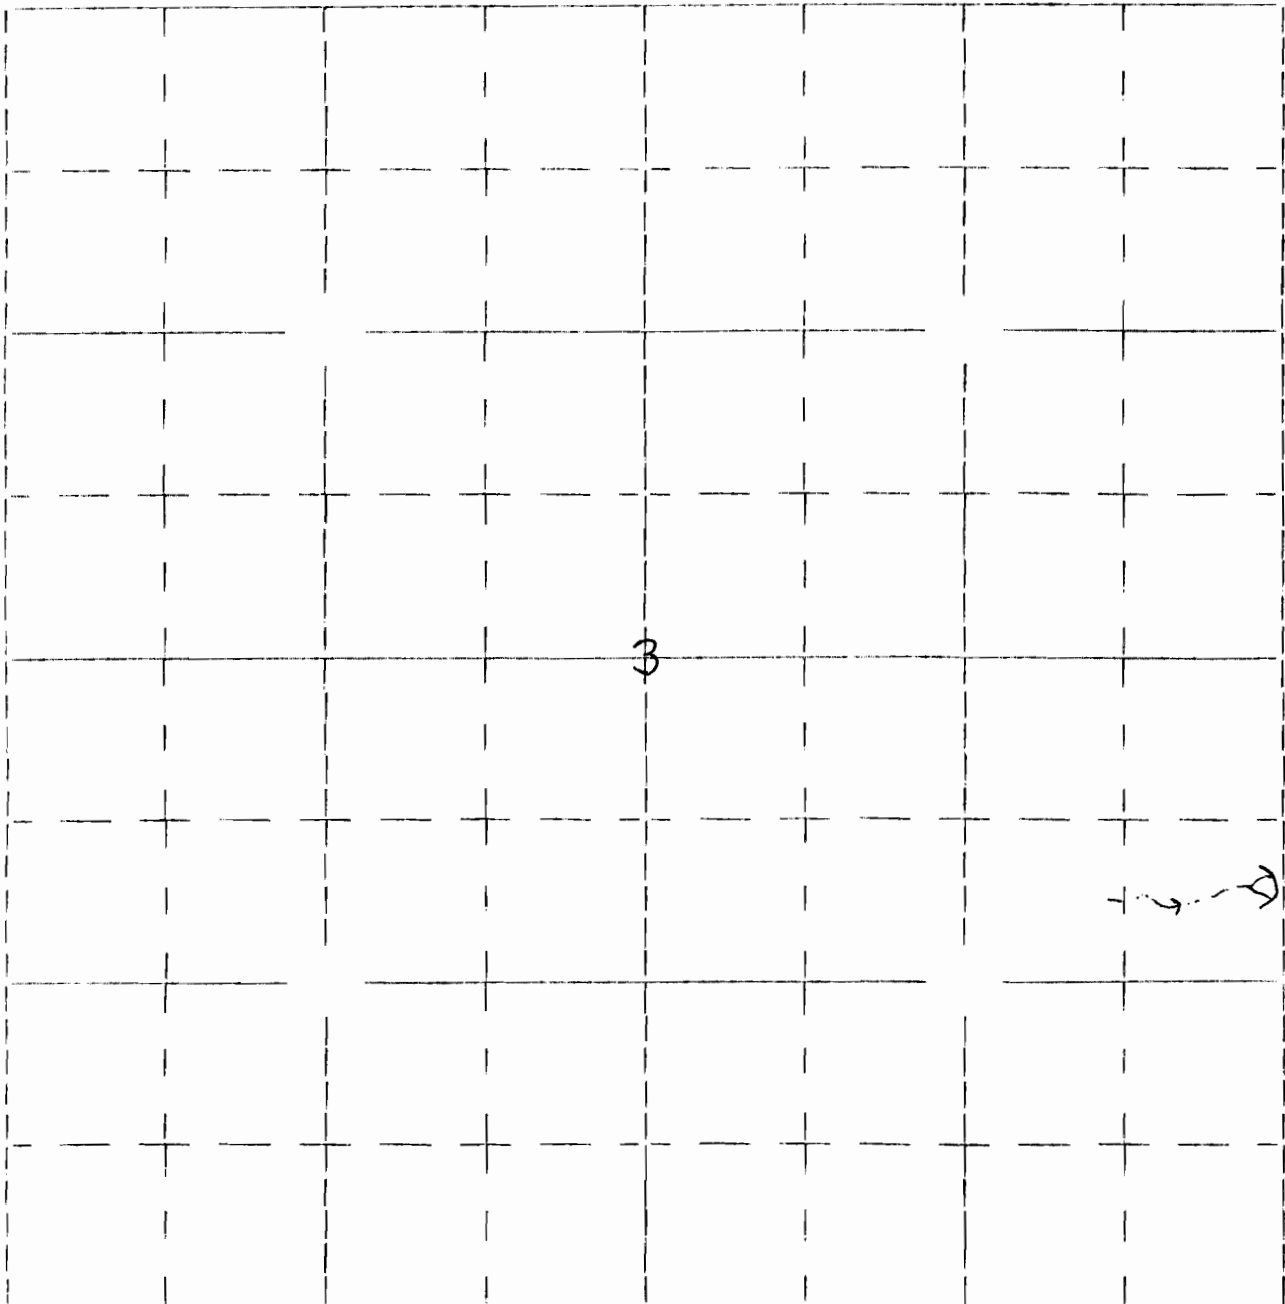

*1675' North and 100' West of the
SE corner of Sec. 3*