


Form OR-010-7300-2
4/83

UNITED STATES
DEPARTMENT OF THE INTERIOR
BUREAU OF LAND MANAGEMENT

Section
SWSE 14
T 36S
R 28E

North Twin
(5519)

Appl. No. R-66286
Permit No. R10571

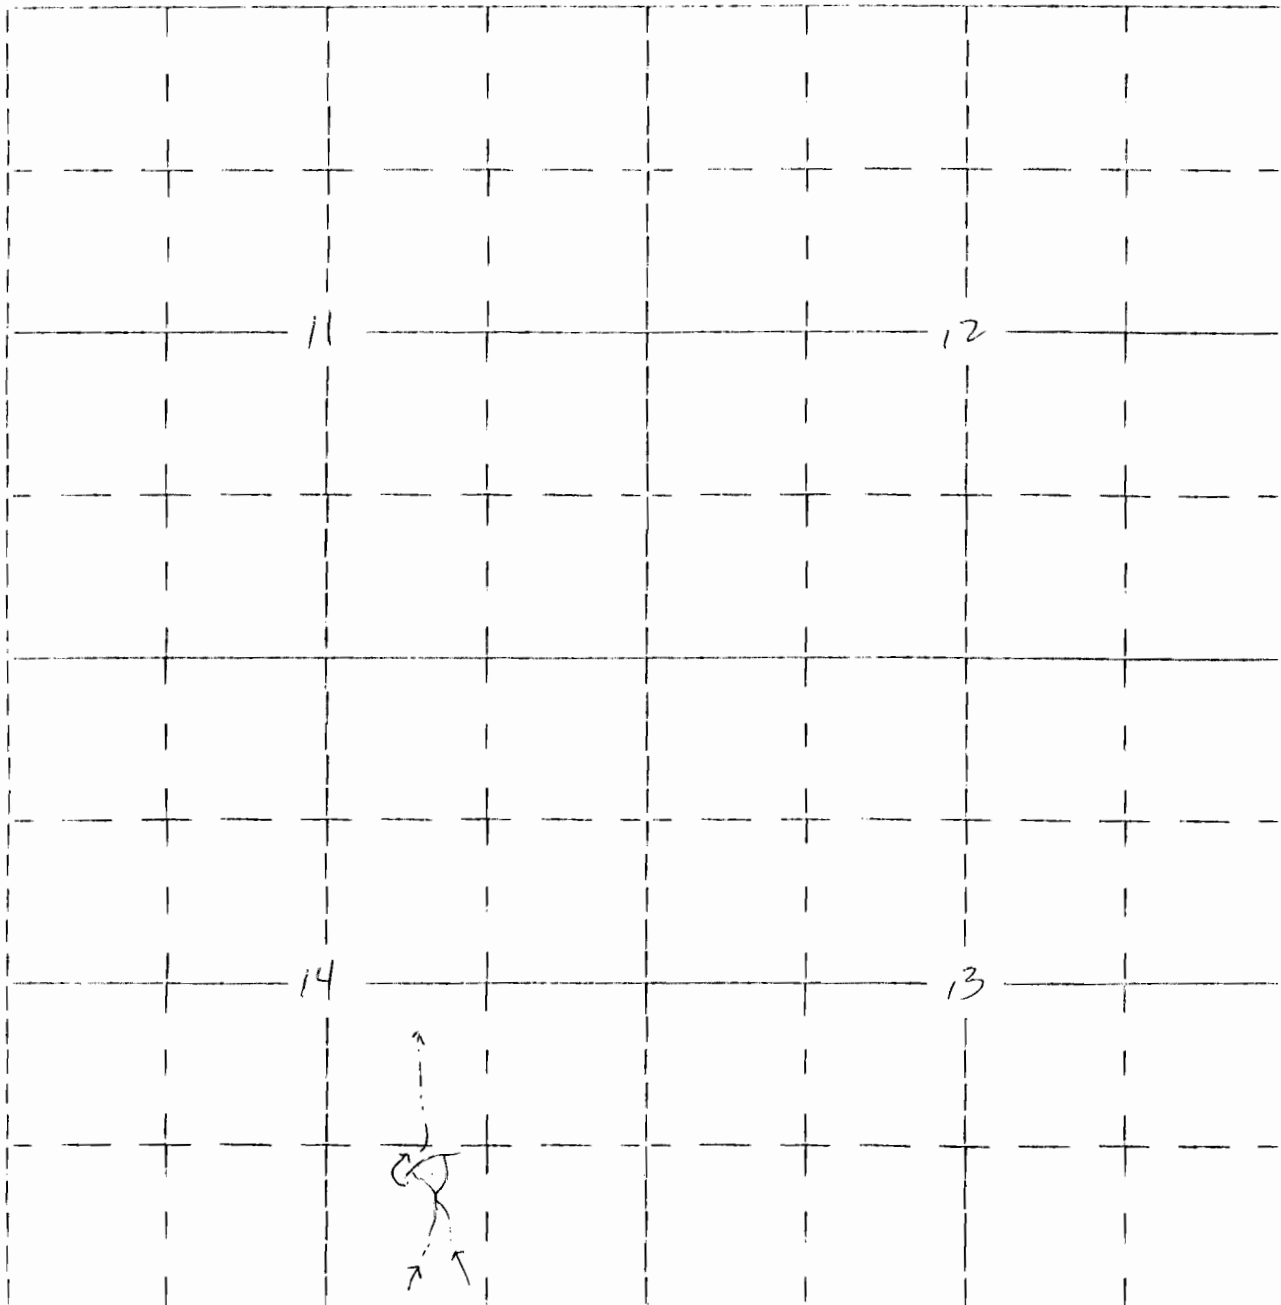

1002' North and 1904' West
of the SE corner, Sec 14.