

Form OR-010-7300-2
4/83

UNITED STATES
DEPARTMENT OF THE INTERIOR
BUREAU OF LAND MANAGEMENT

Section

3 NE SW


T38S

R27E

Juniper Swale
(5510)

Appl. No. R-66290

Permit No. R10575

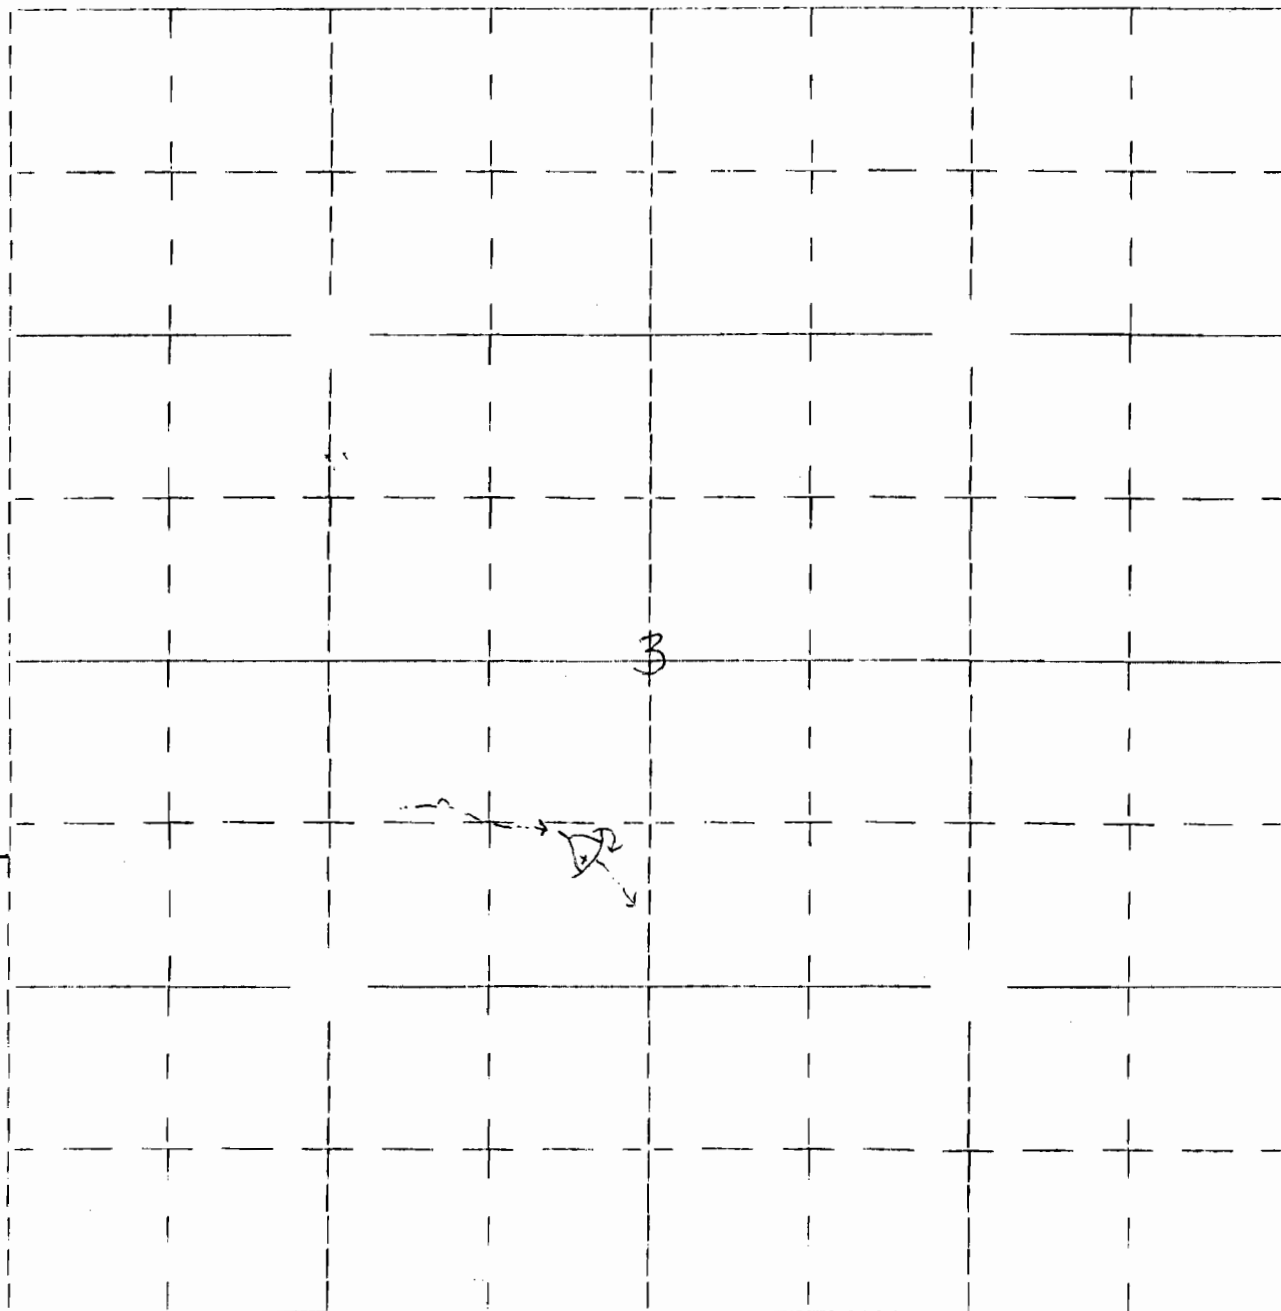

1810' north and 2280' East
of the SW corner of Sec. 3