

67457

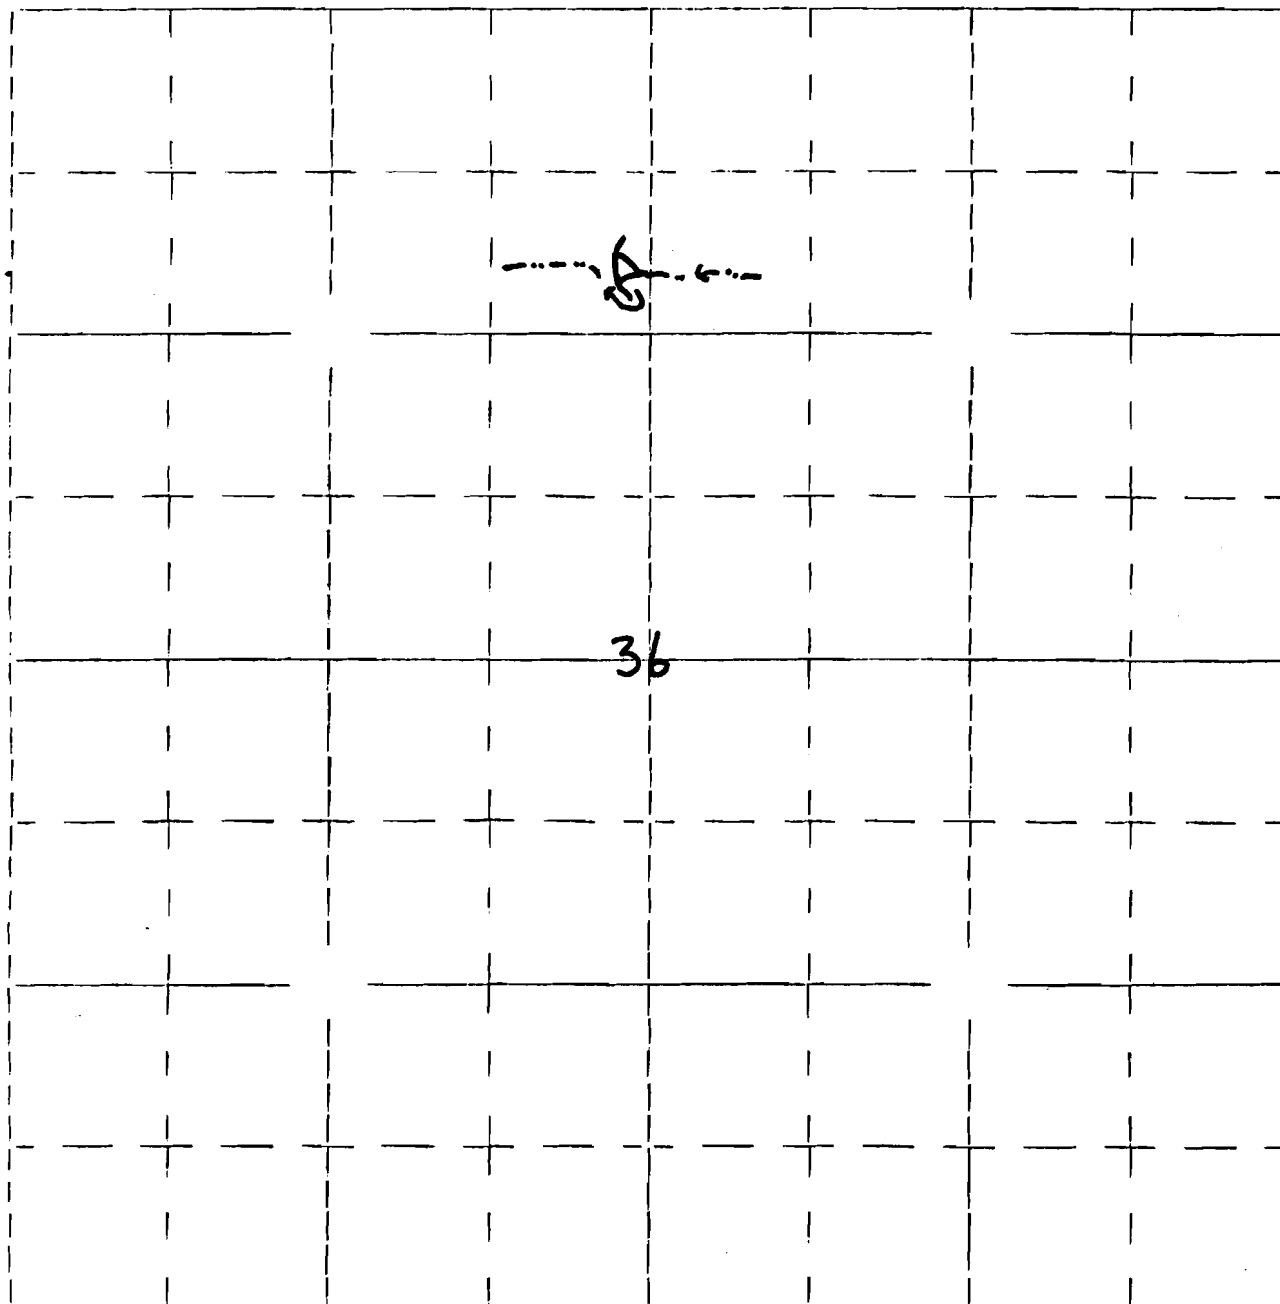
Form OR-010-7300-2
4/83

UNITED STATES
DEPARTMENT OF THE INTERIOR
BUREAU OF LAND MANAGEMENT

Section

36T 38SR 23E

Bedrock RES.
5401

Appl. No. R-66274Permit No. R10578

1070' South & 2480' East of the NW corner
of section 36.