

Form OR-010-7300-2  
4/83

UNITED STATES  
DEPARTMENT OF THE INTERIOR  
BUREAU OF LAND MANAGEMENT

Section

26

Township

40S.

Appl. No.

R-66299

SE NW

Range


22E

Permit No.

R10583

Will. Mer.

Spring W.H. Res. #4060

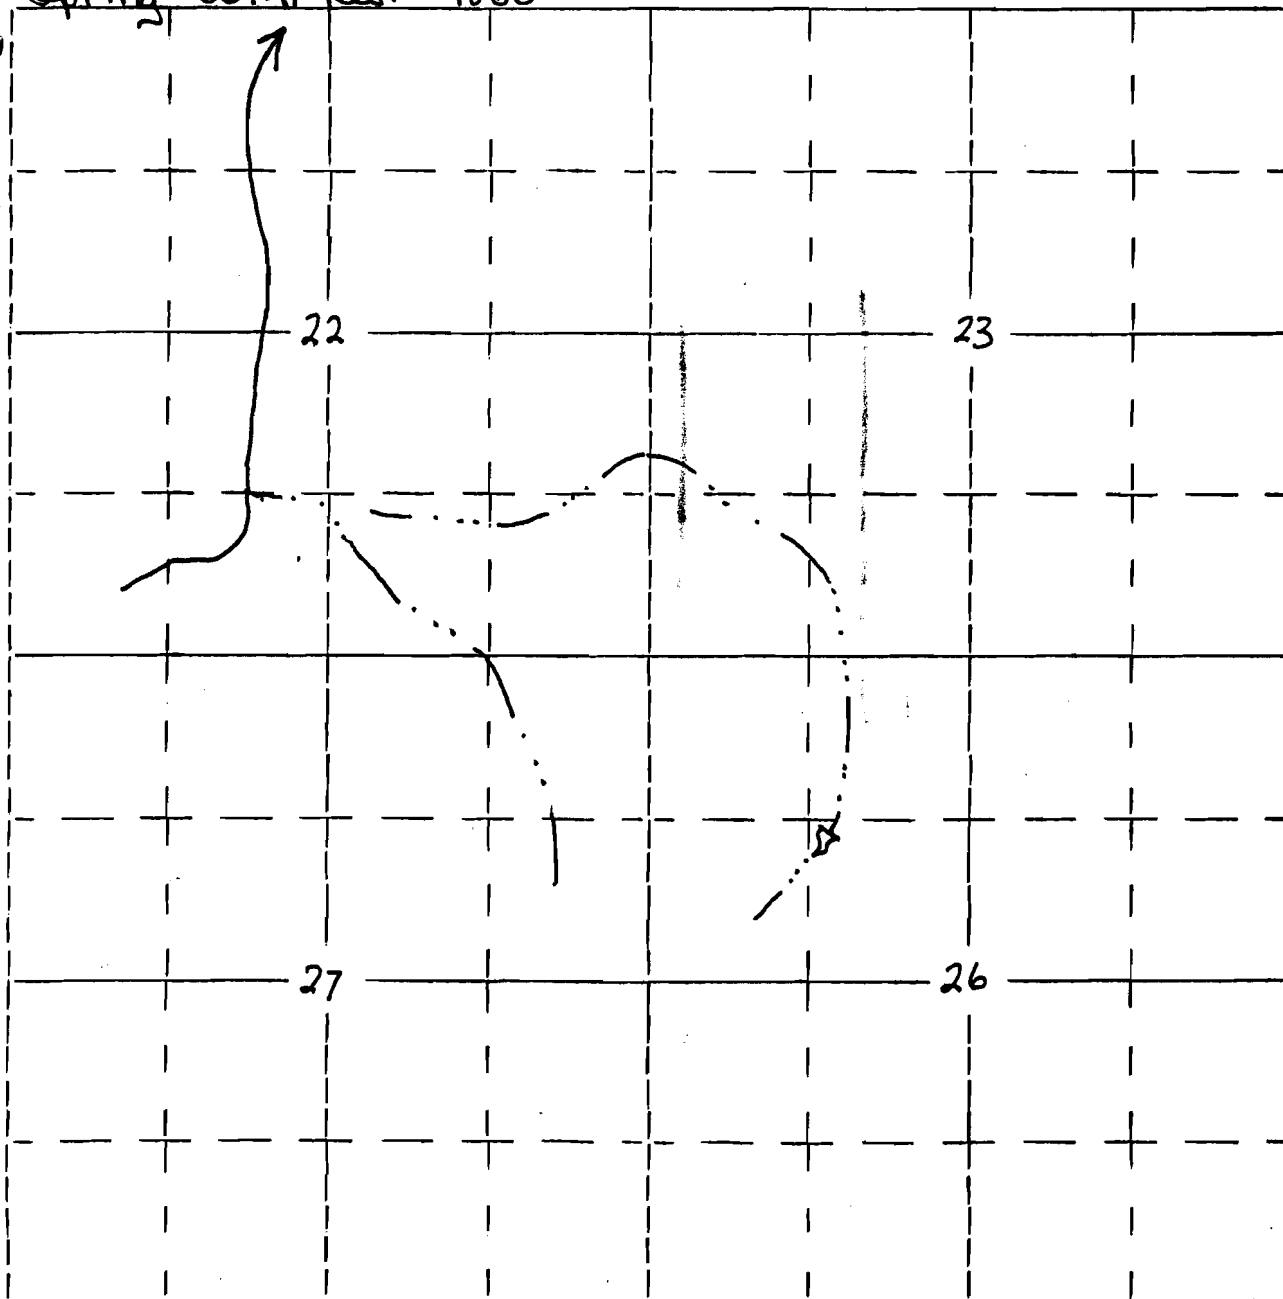

1,400' S., 1,600' E., of NW corner of section 26