

67460

Form OR-010-7300-2
4/83

UNITED STATES
DEPARTMENT OF THE INTERIOR
BUREAU OF LAND MANAGEMENT


Section 13
NW SE

Township 40S
Range 25E

Appl. No. R-66300
Permit No. R10584

Will. Mer.

Stock Trail Res. # 4165

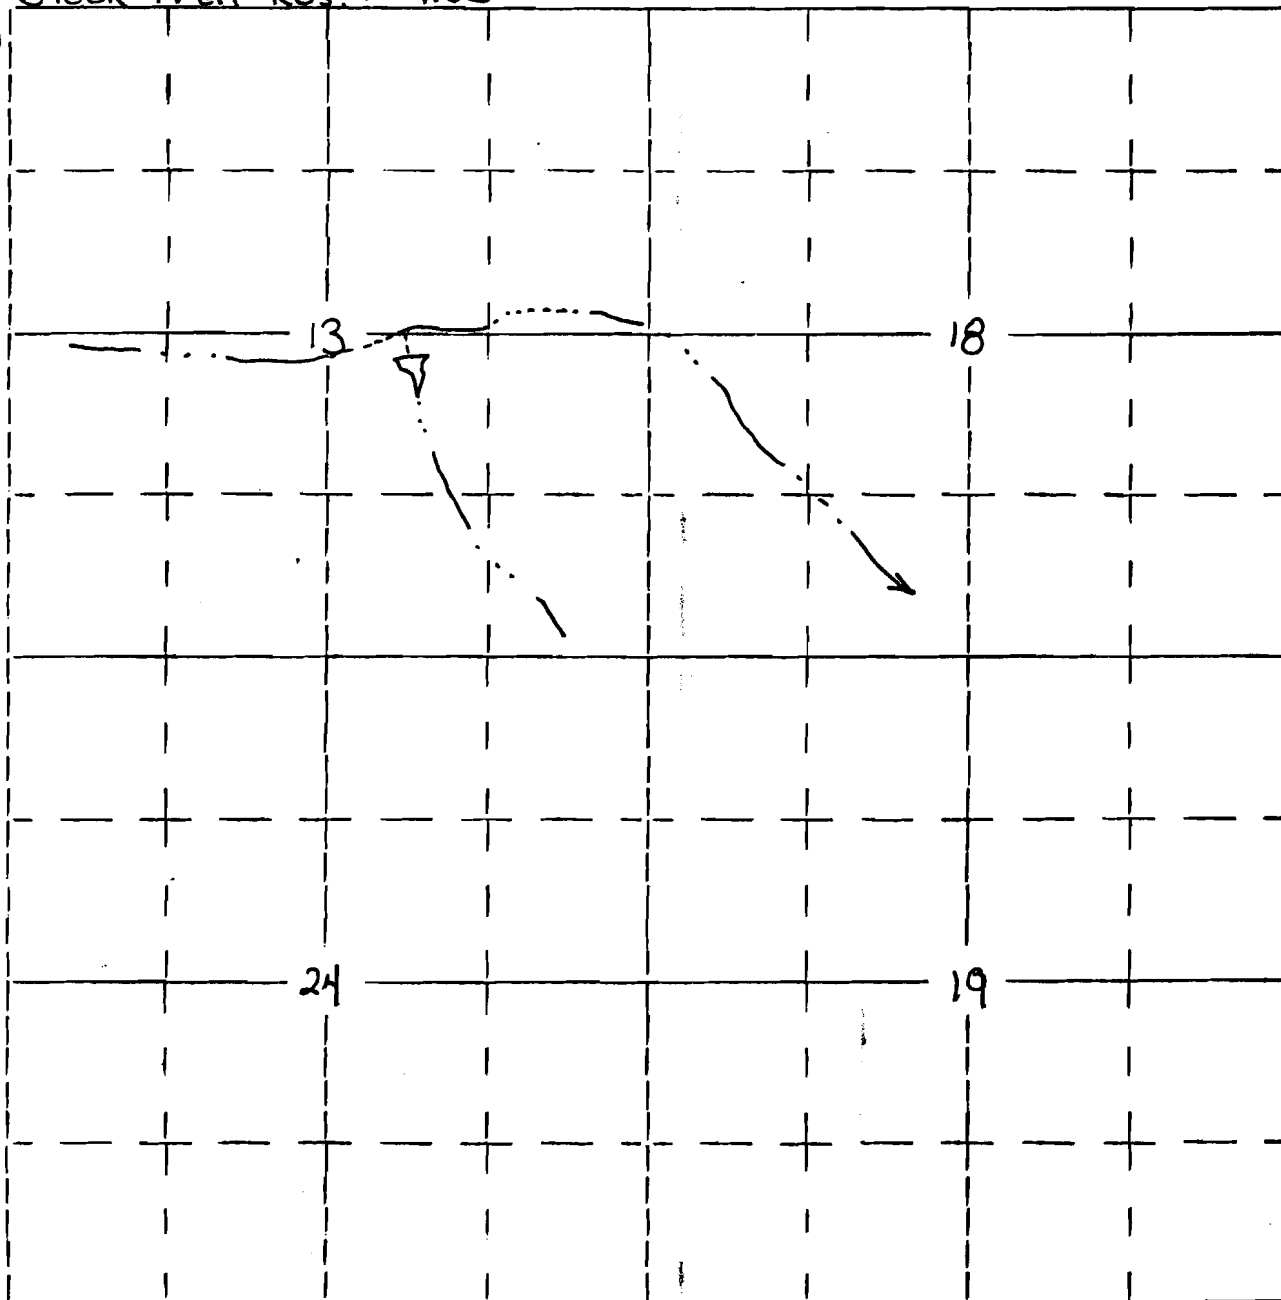

2450' N., 2000' W., of SE corner of Section 13