

Form OR-010-7300-2
4/83

UNITED STATES
DEPARTMENT OF THE INTERIOR
BUREAU OF LAND MANAGEMENT


Section 26
NW NW

Township 40S
Range 25E

Appl. No. R-66302
Permit No. R10586

Will. Mer.

Upper Chuckar Res #5113

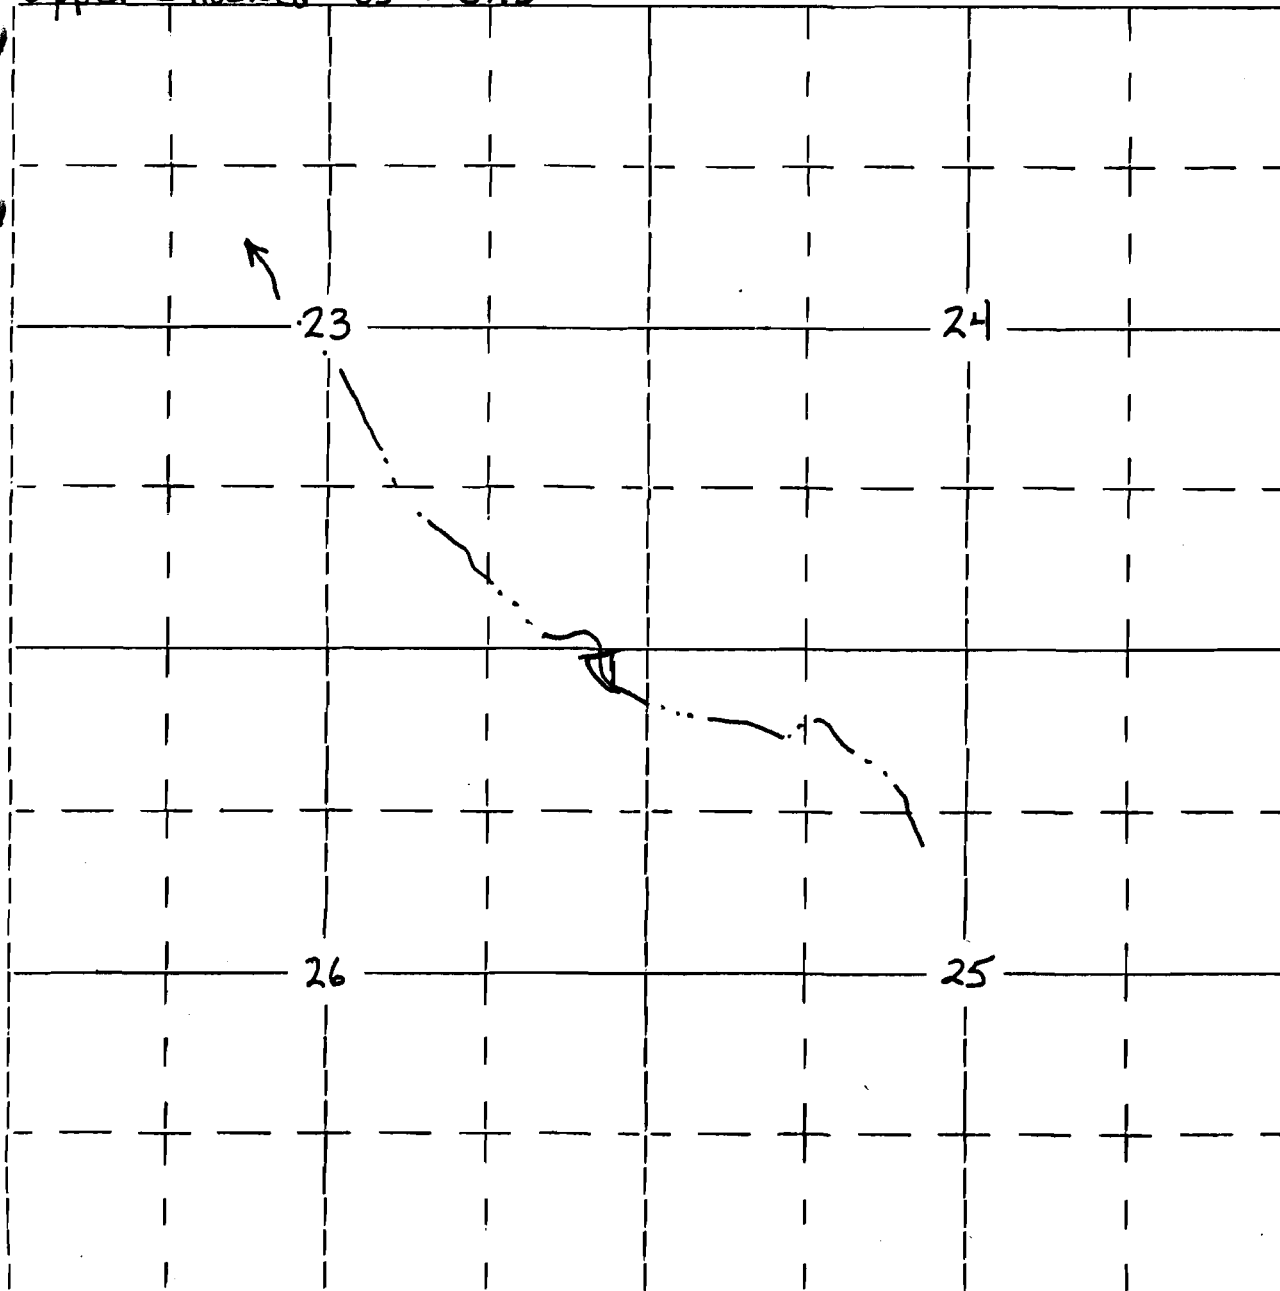

300' S., 550' E., of NE corner of section 26