

Form OR-010-7300-2
4/83

UNITED STATES
DEPARTMENT OF THE INTERIOR
BUREAU OF LAND MANAGEMENT


Section 35
NENW

Township 30S.
Range 23E

Appl. No. R-67364
Permit No. _____

Will. Mer.

Rock Slide W.H. (#0647)

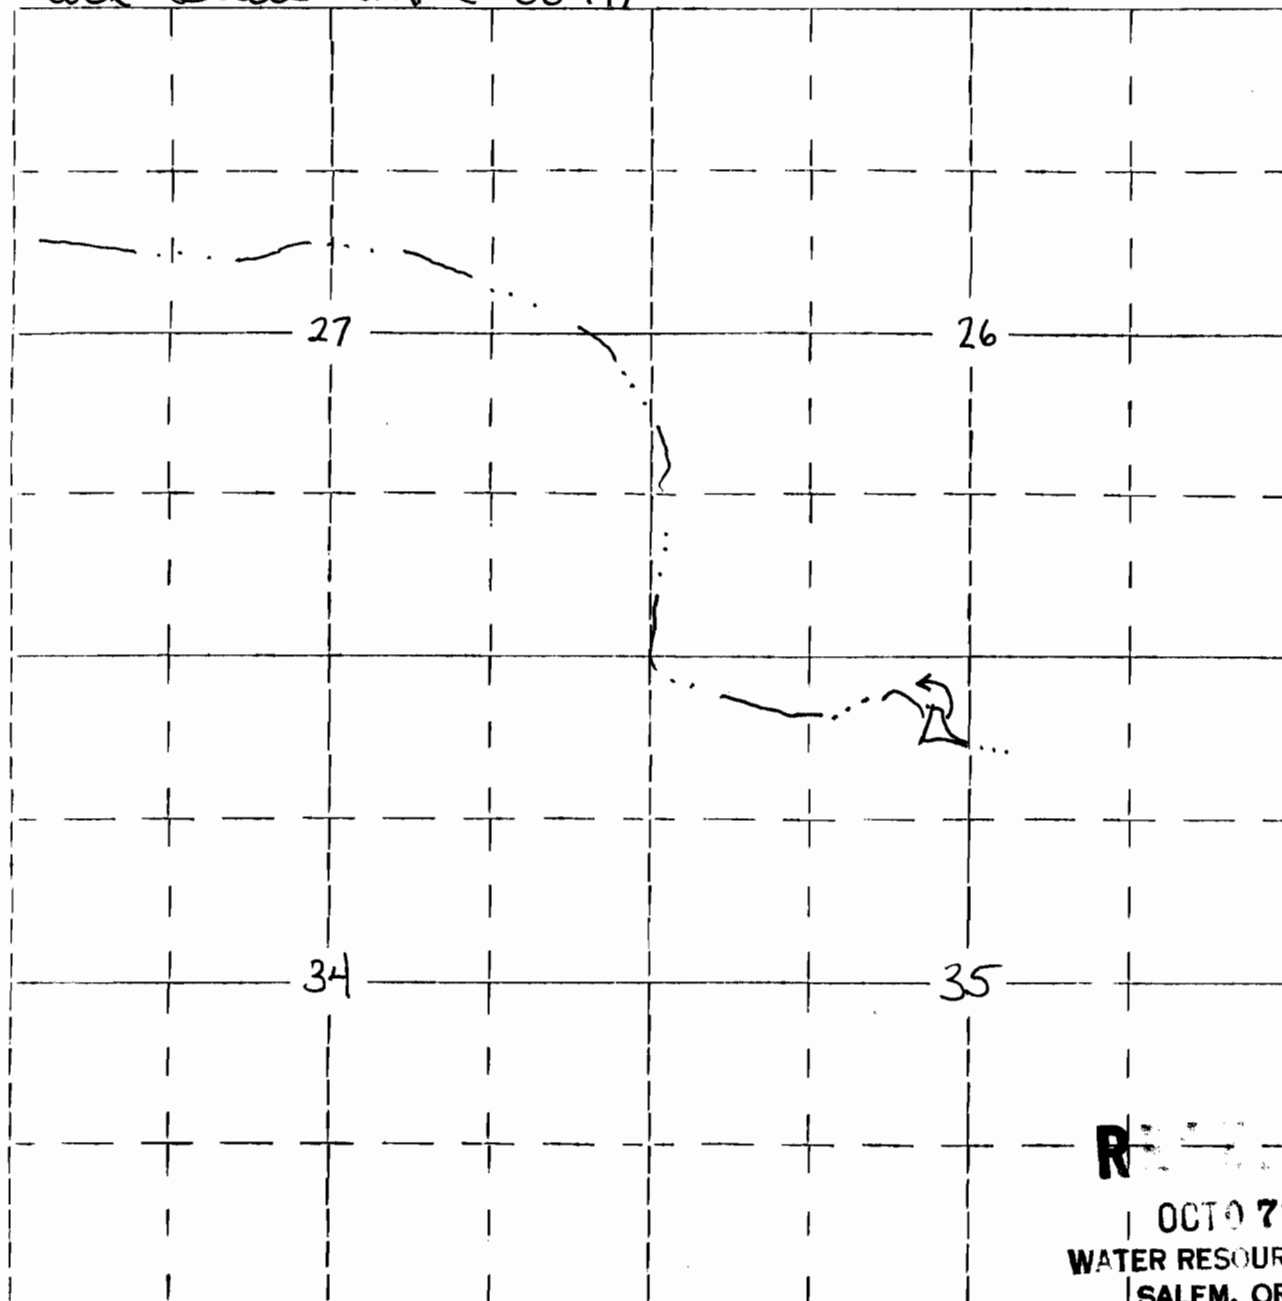

RECEIVED

OCT 7 1983
WATER RESOURCES DEPT.
SALEM, OREGON

700'S. 2,600'E of NW corner of Section 35

Application No. R-67364

Permit No. **R 8946**