

R8947
67466

Form OR-010-7300-2
4/83

UNITED STATES
DEPARTMENT OF THE INTERIOR
BUREAU OF LAND MANAGEMENT


Section 27
SWNE

Township 30S
Range 23E

Appl. No. R-67365
Permit No. _____

Will. Mer.

Conf. Reservoir (#1199)

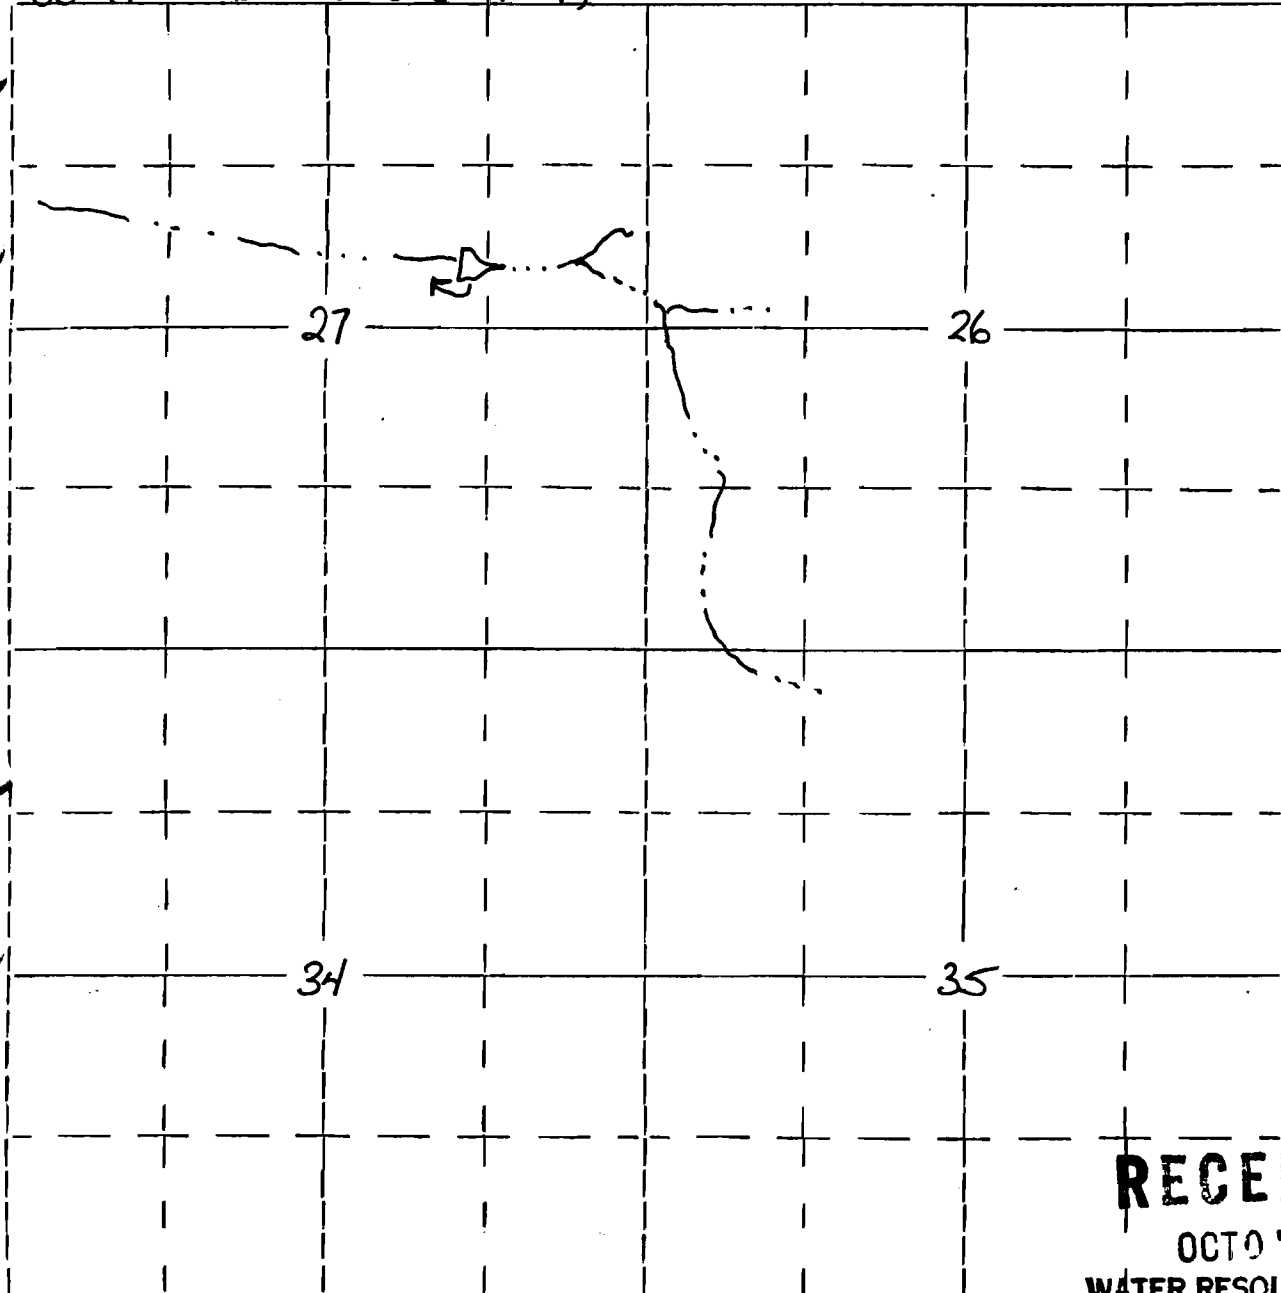

RECEIVED

OCT 07 1983

WATER RESOURCES DEPT.

SALEM, OREGON

2,300 'S. 2,300' W of NE corner of section 27

Application No. R-67365

Permit No. R 8947