

R 8948
67467

Form OR-010-7300-2
4/83

UNITED STATES
DEPARTMENT OF THE INTERIOR
BUREAU OF LAND MANAGEMENT


Section 5
SE NW

Township 32 S
Range 26 E

Appl. No. R-67366
Permit No. _____

Will. Mer.

Knob Reservoir (# 4051)

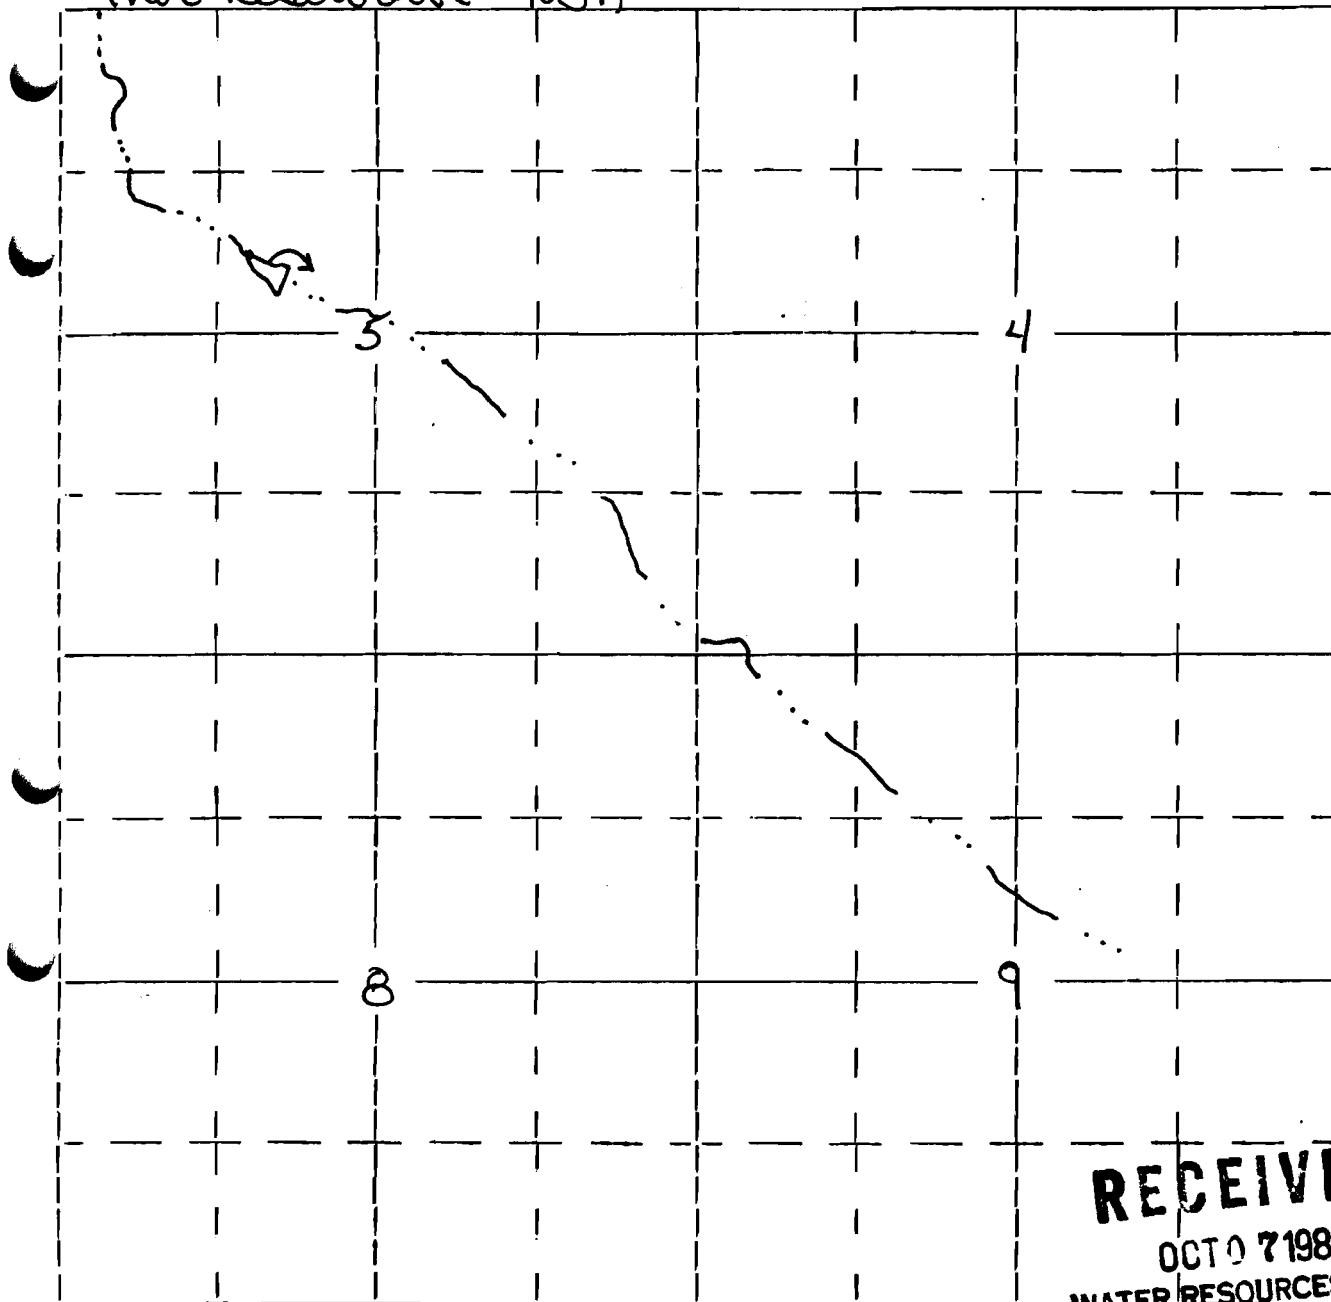

2,400' S, 1,700' E. of NW corner of Section 5

Application No. R-67366

Permit No. R 8948

RECEIVED
OCT 7 1983
WATER RESOURCES DEPT.
SALEM, OREGON