

R8949
67468

Form OR-010-7300-2
4/83

UNITED STATES
DEPARTMENT OF THE INTERIOR
BUREAU OF LAND MANAGEMENT


Section 33
SENE

Township 31S
Range 26E

Appl. No. R-67367
Permit No. 1

Will. Mer.

Lynch's Draw Reservoir (#4052)

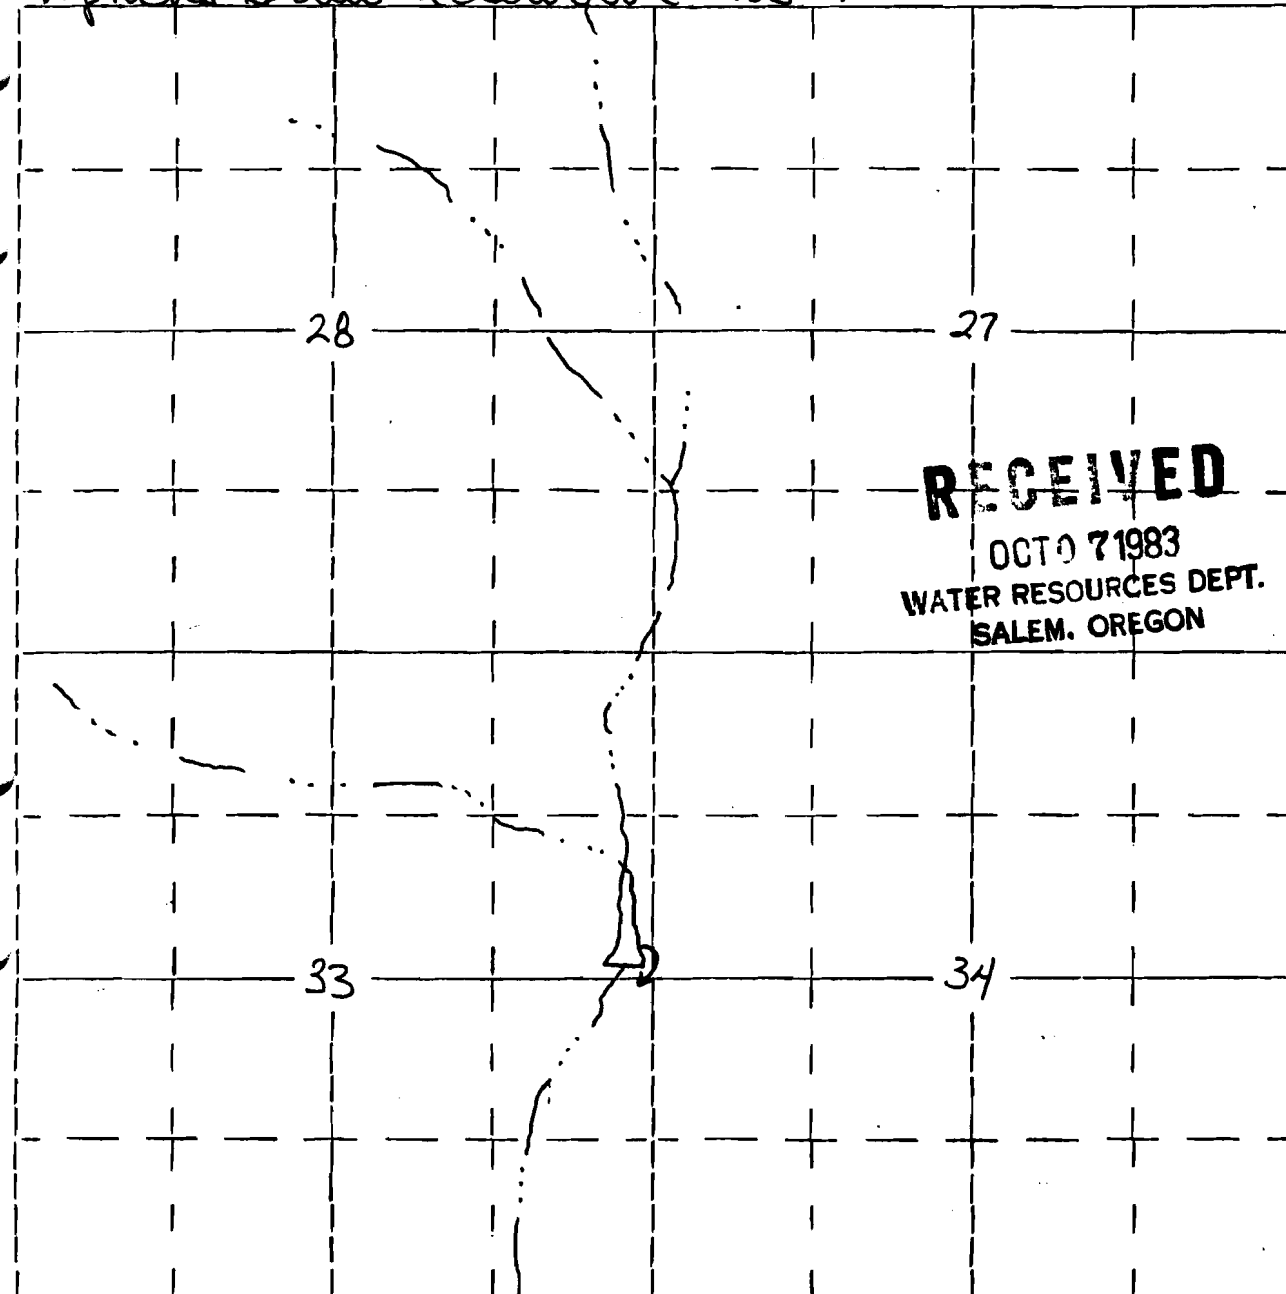

2300's 200' W of NE corner of section 33.

Application No. R-67367
Permit No. R 8949