

R8950
67469

Form OR-010-7300-2
4/83

UNITED STATES
DEPARTMENT OF THE INTERIOR
BUREAU OF LAND MANAGEMENT

Section

34

Township 37S

Appl. No. R-67370


NWNW

Range 23E

Permit No. _____

Will. Mer.

San Waterhole (#0957)

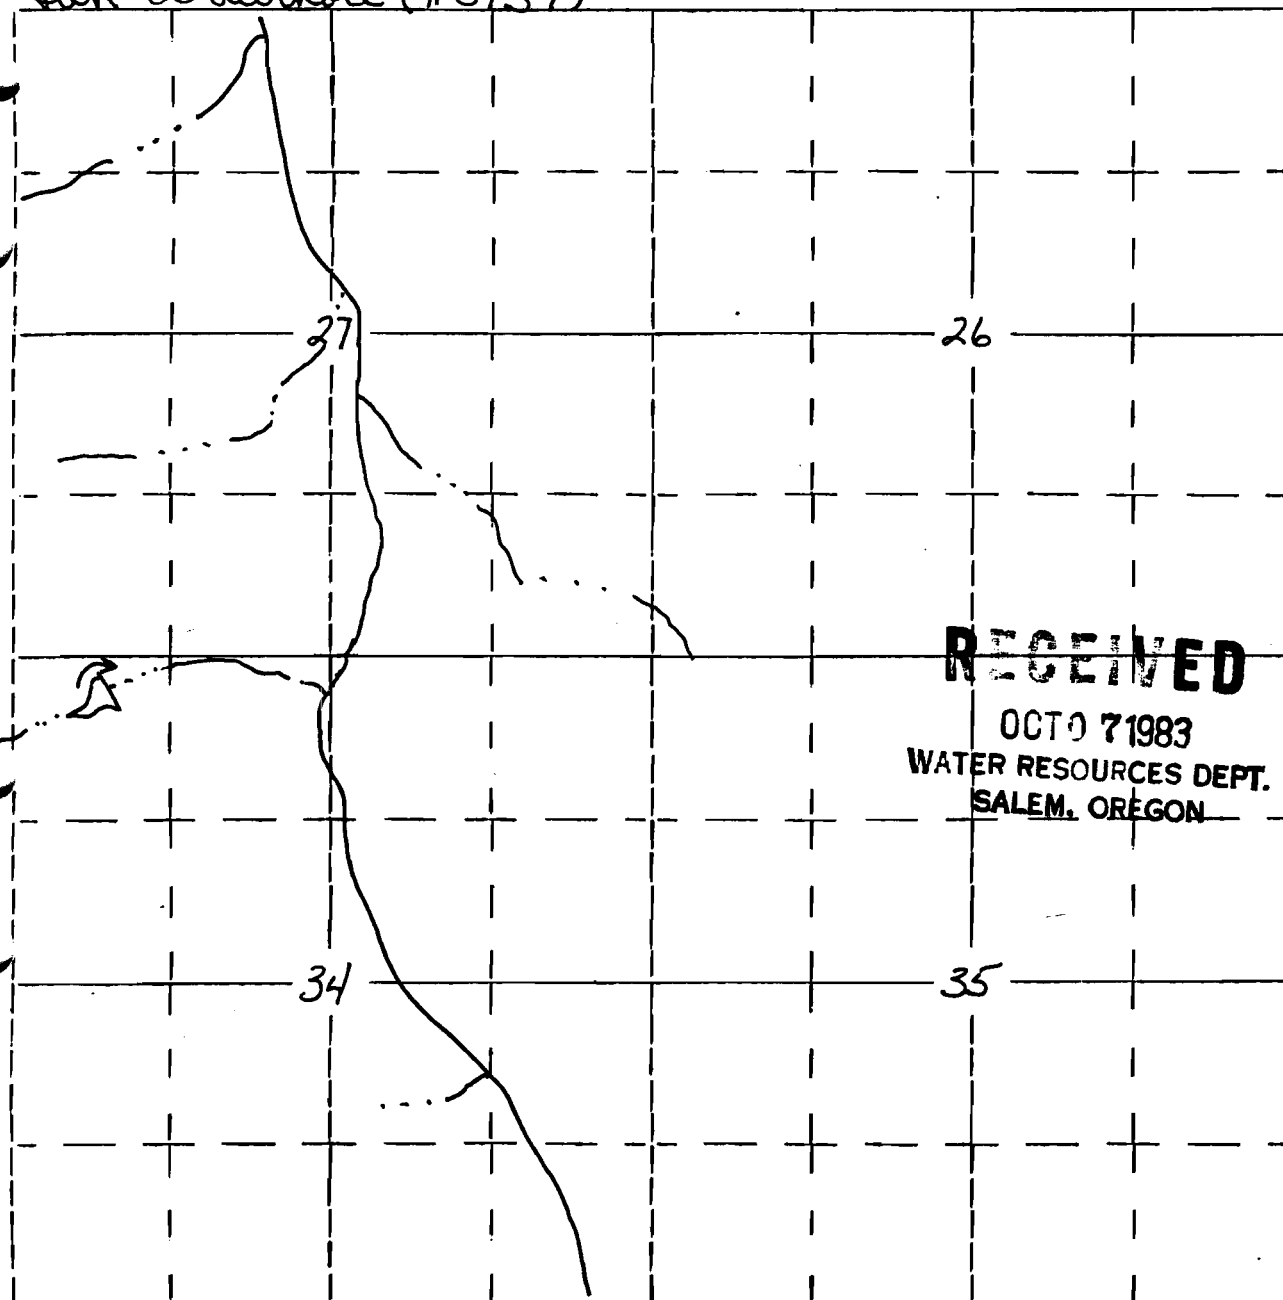

RECEIVED

OCT 7 1983

WATER RESOURCES DEPT.
SALEM, OREGON

350'S. 500'E of the NW corner of section 34

Application No. R-67370

Permit No. _____

R 8950