

R8952
67471

Form OR-010-7300-2
4/83

UNITED STATES
DEPARTMENT OF THE INTERIOR
BUREAU OF LAND MANAGEMENT


Section 9
SE SW

Township 33S
Range 23E

Appl. No. R-67372
Permit No. R 8952

Will. Mer.

Junction Waterhole (#4680)

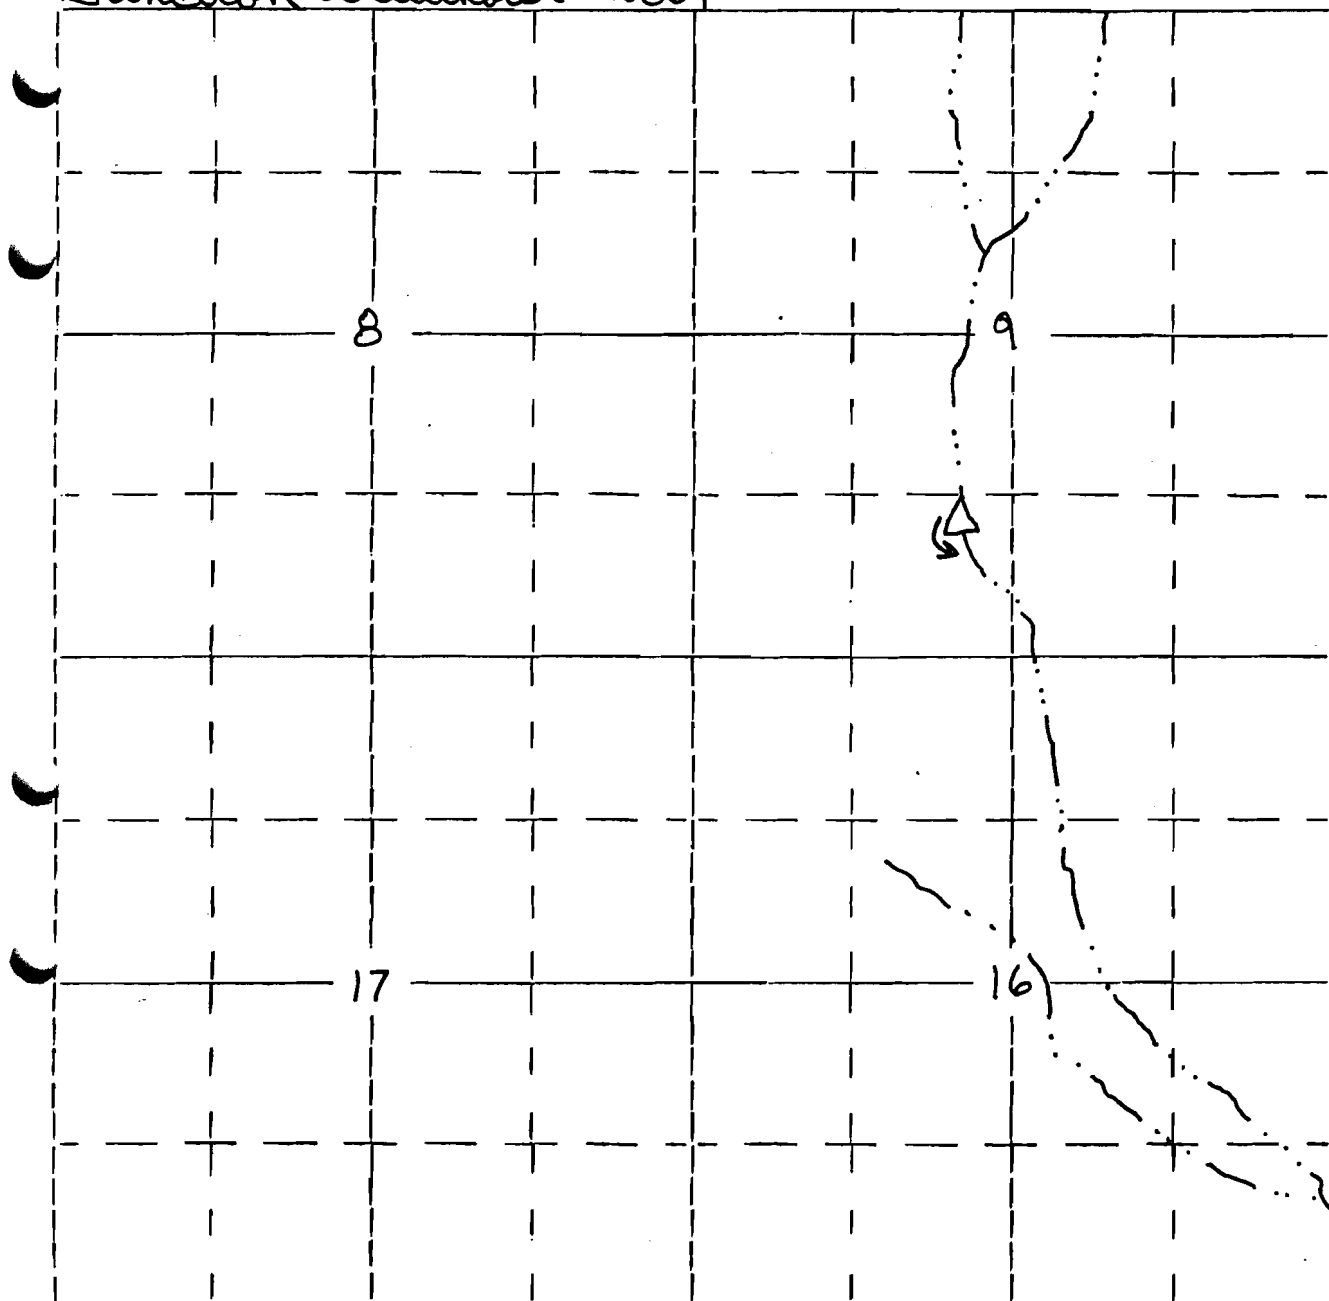

950' N. 2500' E of SW corner of section 9.

RECEIVED
OCT 9 7 1983
WATER RESOURCES DEPT.
SALEM, OREGON