

R 8953
67472

Form OR-010-7300-2
4/83

UNITED STATES
DEPARTMENT OF THE INTERIOR
BUREAU OF LAND MANAGEMENT

Section

22

Township 33S

Appl. No. R-67373


NW3W

Range 23E

Permit No. R 8953

Will. Mer.

Sand Reservoir #1500

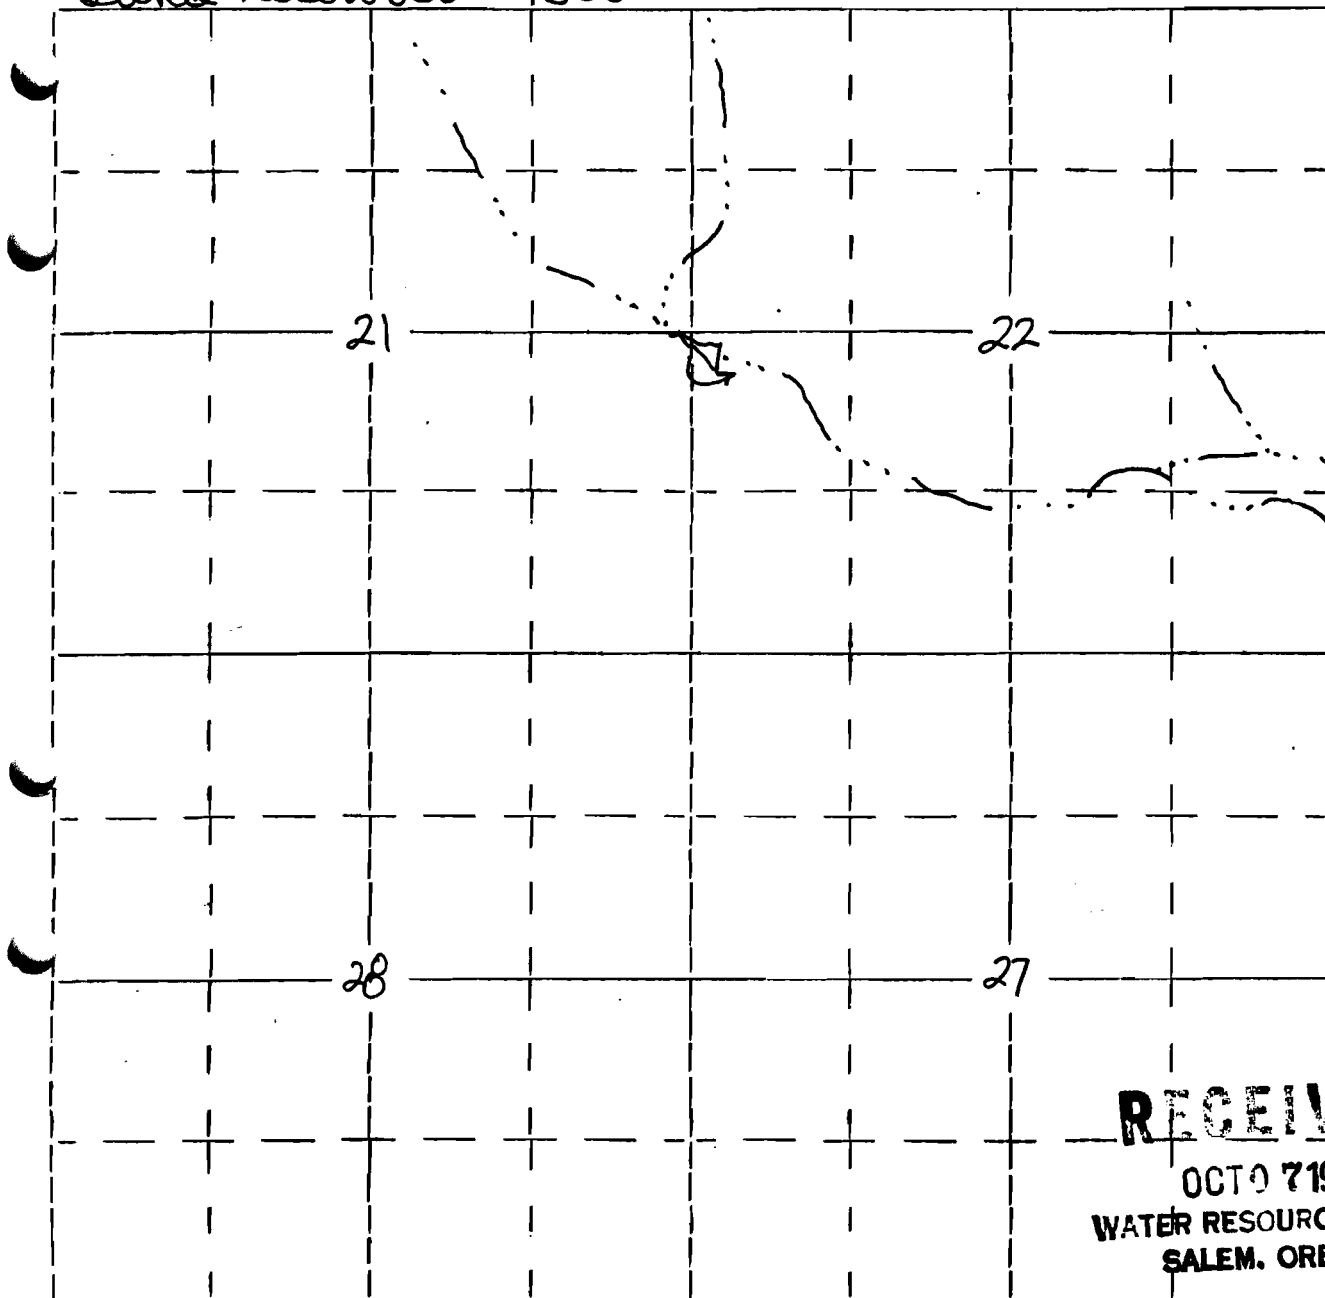

RECEIVED

OCT 17 1983
WATER RESOURCES DEPT.
SALEM, OREGON

2600'N, 250'E of the SW corner of section 22