

R 8954
67473

Form OR-010-7300-2
4/83

UNITED STATES
DEPARTMENT OF THE INTERIOR
BUREAU OF LAND MANAGEMENT


Section 30
SESE

Township 37S
Range 24E

Appl. No. R-67374
Permit No. R 8954

Will. Mer.

King Reservoir #1467

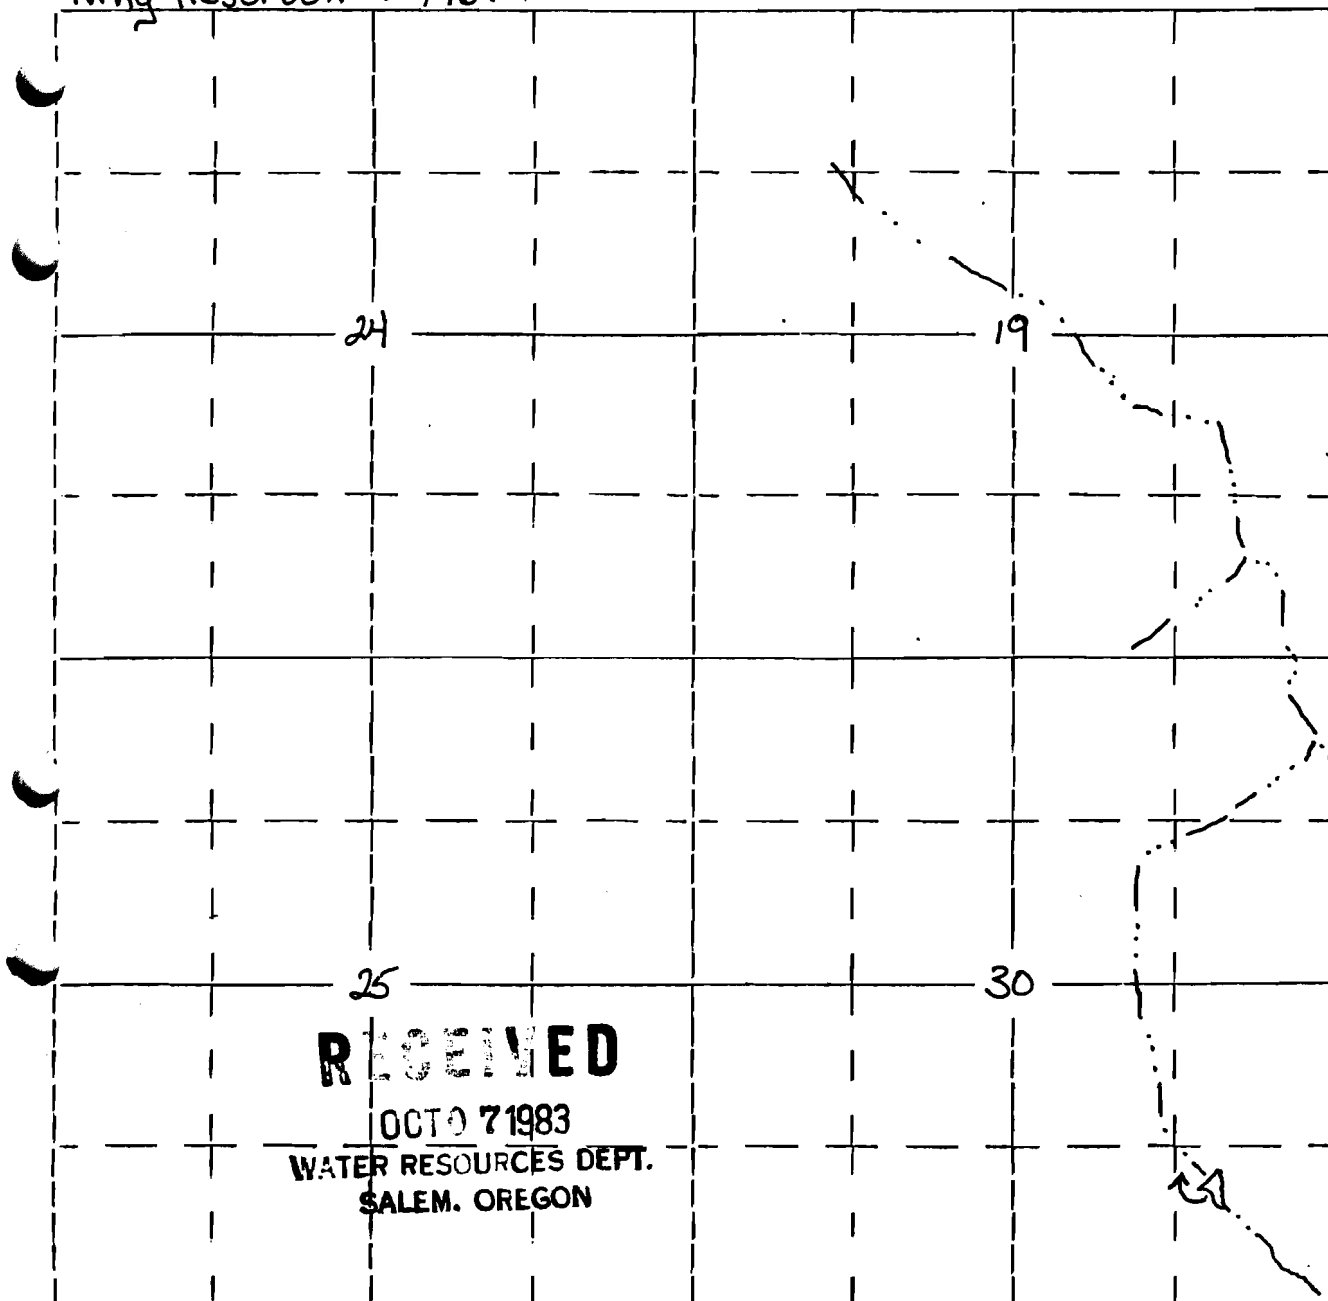

750' N 500' W of the SE corner of Section 30