

R8956
67475

Form OR-010-7300-2
4/83

UNITED STATES
DEPARTMENT OF THE INTERIOR
BUREAU OF LAND MANAGEMENT

Section 13

Township 35S

Appl. No. R-67376


NESW

Range 21E

Permit No. R 8956

Will. Mer.

Shad Reservoir #1496

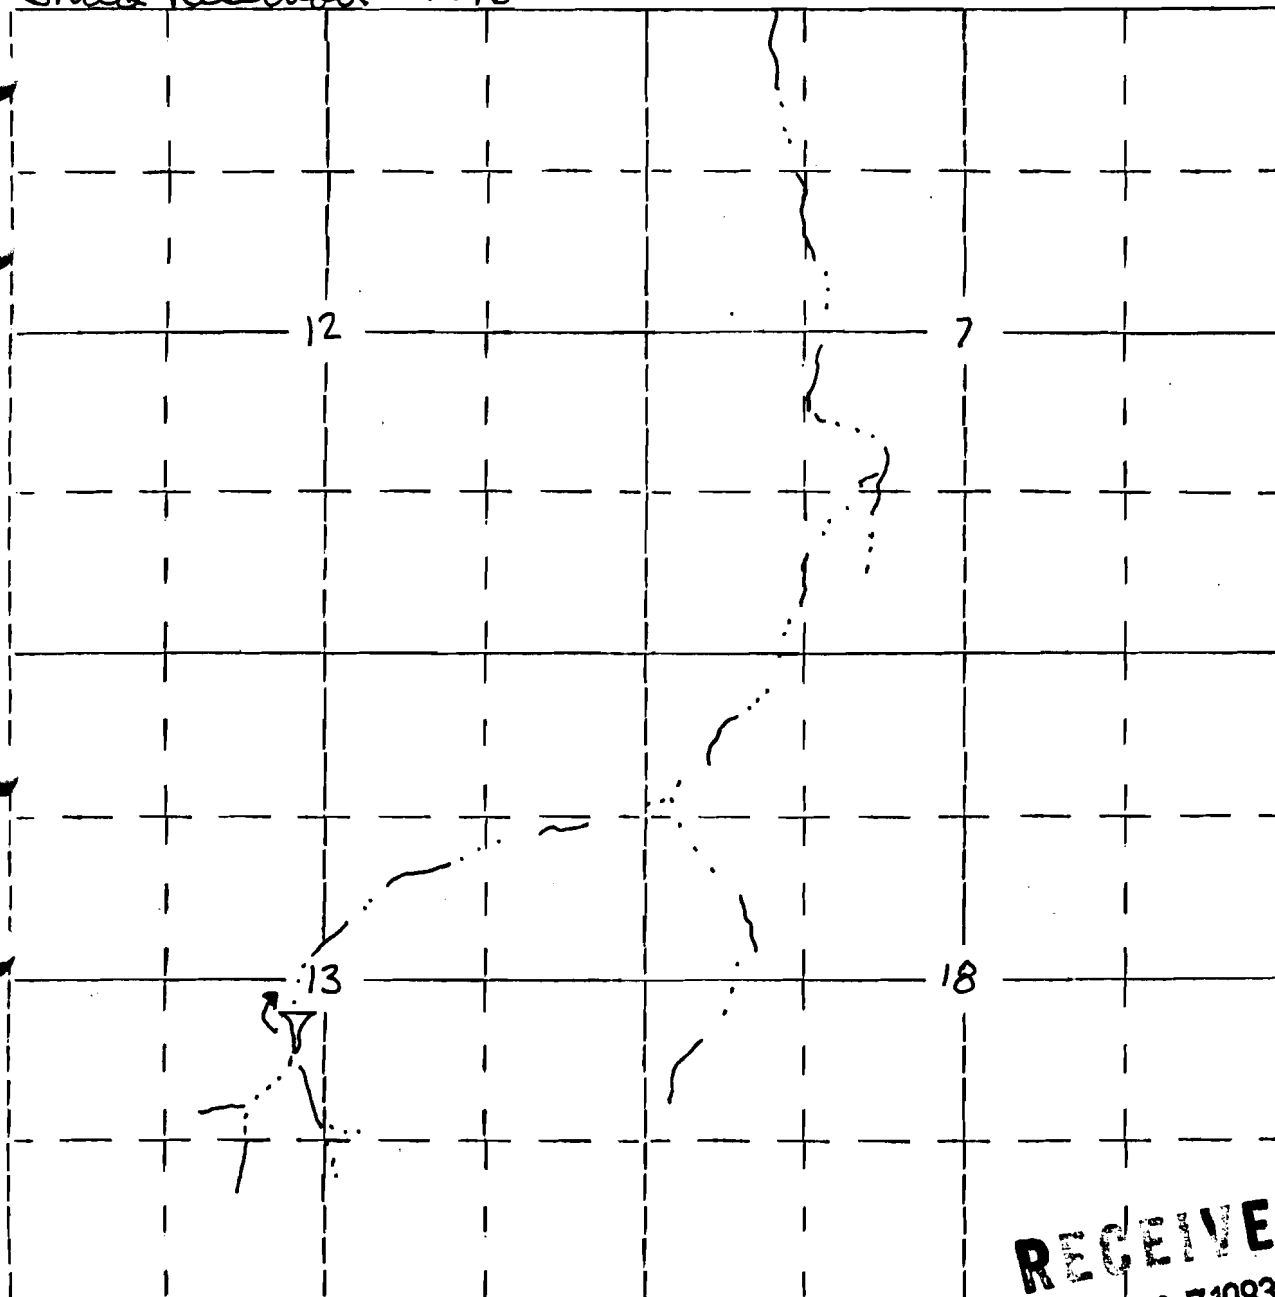

2150' N, 2,350' E of SW corner of section 13

RECEIVED

OCT 17 1983
WATER RESOURCES DEPT.
SALEM, OREGON