

R8958
67476

Form OR-010-7300-2
4/83

UNITED STATES
DEPARTMENT OF THE INTERIOR
BUREAU OF LAND MANAGEMENT

Section
16

Township 31 south

Appl. No. R-67379


SWSE

Range 26 east

Permit No. R 8958

Will. Mer.

Hidden Reservoir # 1454

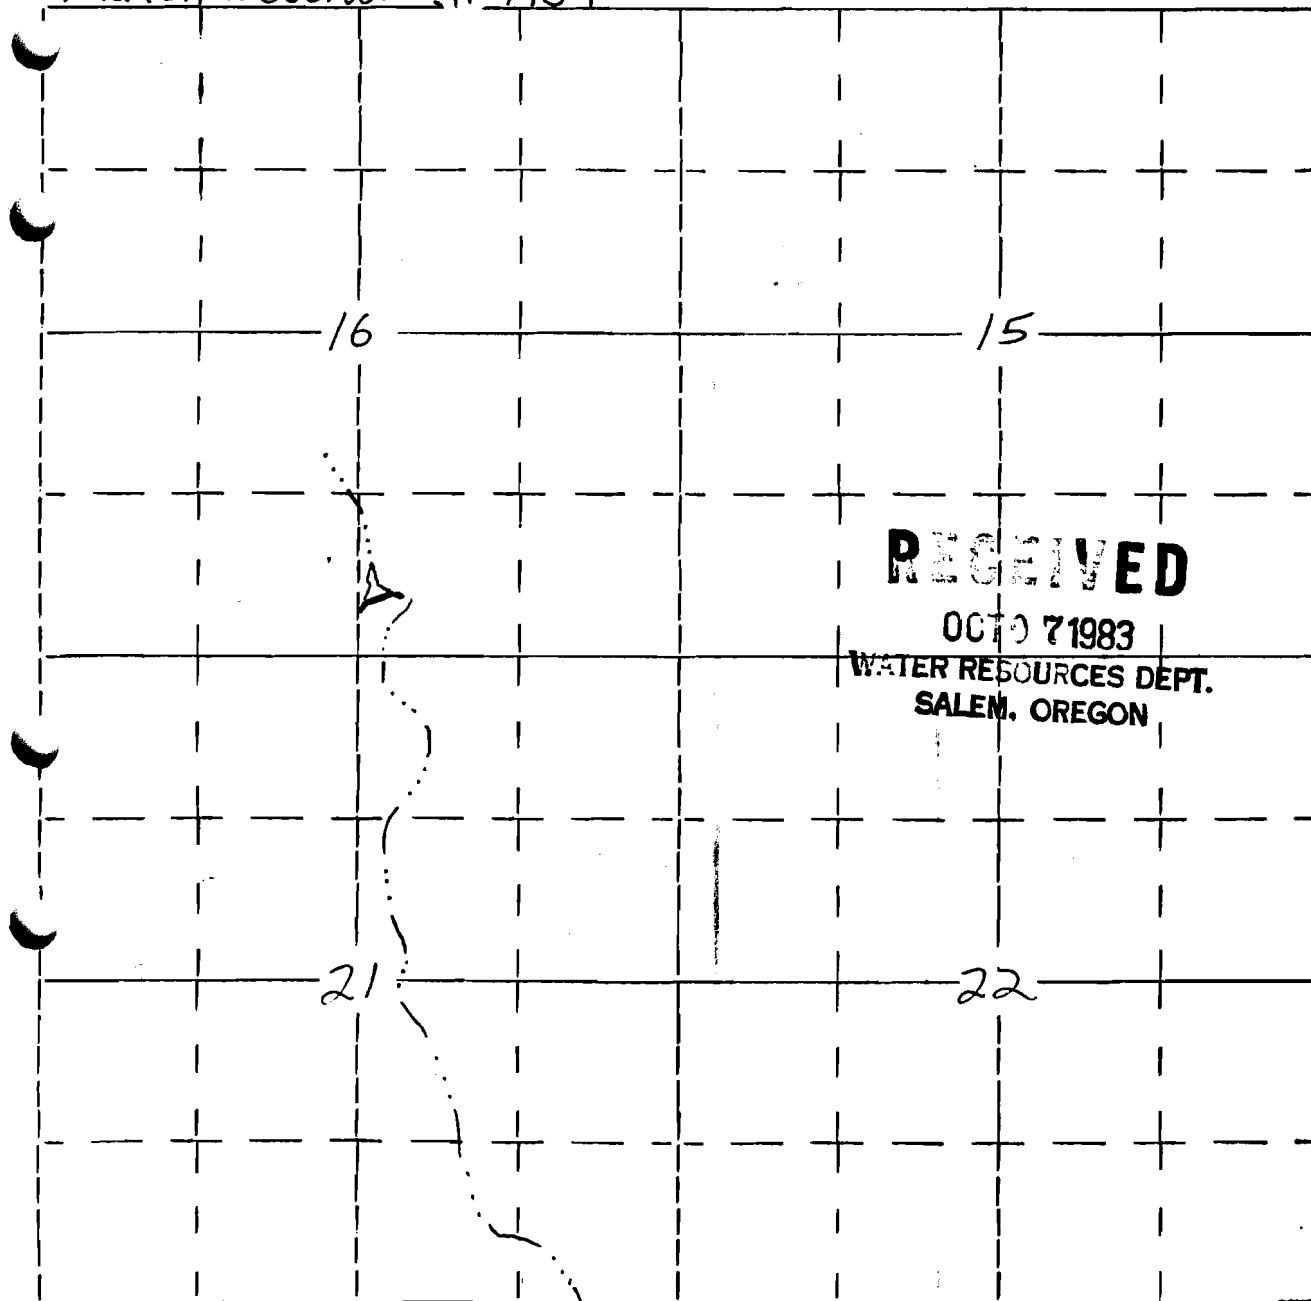

330' N., 2310' W. of SE Corner of Section 16